

LAUD.

MISSISSIPPI BOARD OF WATER COMMISSIONERS

020


WATER WELL DRILLERS LOG

6-4-64

Date: 6/4, 1964, Driller: Jerry OVERSTREET County LAUD

(Name)

(1) Owner of Land: <u>H.H. RAWSON</u> (Name)	Description & Color of Materials Sand, Clay, Red Clay, Shell, etc.	Thick- ness Feet	Depth Feet
<u>RT6, MERIDIAN, MISS</u> (Address)	<u>yellow clay</u>	<u>30'</u>	<u>30'</u>
(2) Location: <u>1/4, 1/4, Sec. 7</u> <u>6N16E</u> T. R. <u>5 miles EAST</u> of <u>MDN.</u> (distance) (direction) (Nearest Town)	<u>Blue dirt &amp; shale</u> <u>SAND STREAKS</u>	<u>300</u> <u>60</u>	<u>330</u> <u>390'</u>
(3) Topography: <u>FLAT</u> (Hilly) (Flat) (Level)			
(4) Purpose of Well: <u>DOMESTIC</u> (Domestic Irrigation Municipal, Industrial, Other)			
Information upon completion of well:			
(1) Diameter <u>4</u> inches.			
(2) Total Depth <u>390</u> feet.			
(3) Water Level <u>160'</u> feet below top of ground.			
(4) Cased to <u>234'</u> , Size <u>4"</u>			
(5) Screen: Size <u>NO</u> , Length _____			
(6) Were any formations sealed against pollution? _____ yes, <input checked="" type="checkbox"/> no.			
If YES depth of formation _____			
Why _____			
Drillers Remarks: <u>pumps</u> <u>approx 6 9 PM</u>			

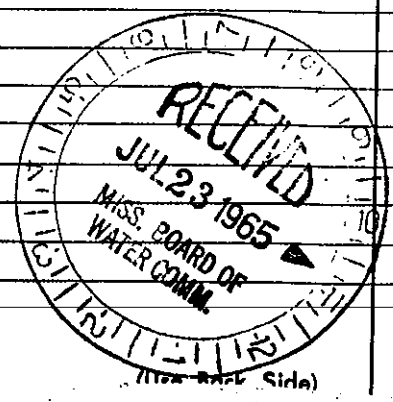

Well No.