

MISSISSIPPI BOARD OF WATER COMMISSIONERS

LAUD.

O 21
2-14-63

WATER WELL DRILLERS LOG

Date: 2-14, 1963, Driller: Mc Donald - Hicc County Cauderdale
(Name)

(1) Owner of Land: Ben Brantley
(Name)
Rt 7 Meridian
(Address)

(2) Location: $\frac{1}{4}$, $\frac{1}{4}$, Sec. 8 ^{64 NE} T R
6 miles E of Meridian
(distance) (direction) (Nearest Town)

(3) Topography: (Hilly) (Flat) (Level)

(4) Purpose of Well: Domestic
(Domestic Irrigation, Municipal, Industrial, Other)

Description & Color of Materials Sand, Clay, Red Clay, Shell, etc.	Thick- ness Feet	Depth Feet
Clay	0	8
Sand - clay	8	25
B shale	25	70
Sand - shale	70	85
Med. Shale	85	100
Sandy sand	100	110
Med shale	110	130
Hard lime rock	135	13
lime + shale	137	150
Med shale	150	167
Sand	167	170
lime rock	170	171
fine sand	171	190
Sandy shale	195	200
fine sand	205	210
Sandy shale	210	220
	220	22

Information upon completion of well:

(1) Diameter 4 inches.

(2) Total Depth 225 feet.

(3) Water Level 180 feet below top of ground.

(4) Cased to 161, Size 4"


(5) Screen: Size ✓, Length ✓

(6) Were any formations sealed against pollution?
✓ yes, no.

If YES depth of formation _____

Why _____

Drillers Remarks: _____

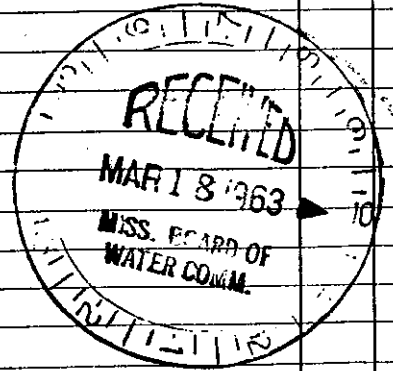

(Use Back Side)

Mail this copy to Board of Water Commissioners 429 Miss. St. Jackson, Miss.

Well No.