

LAUD. MISSISSIPPI BOARD OF WATER COMMISSIONERS

022 WATER WELL DRILLERS LOG

12-15-62
 Date: 12-15-62, Driller: Mc Donald - Hill County, Louisiana

(1) Owner of Land: W.W. Thompson
 (Name)
Vinville, Miss.
 (Address)

(2) Location: 96N16E
7 miles East of Medden
 (distance) (direction) (Nearest Town)

(3) Topography: (Hilly) (Flat) (Level)

(4) Purpose of Well: Domestic
 (Domestic Irrigation, Municipal, Industrial, Other)

Description & Color of Materials Sand, Clay, Red Clay, Shell, etc.	Thick- ness Feet	Dep Feet
Clay	0	19
Sand	19	35
med shale	35	60
Sand	60	65
Hard lime	65	68
Sand	68	95
Med. Shale	95	160
Med. Shale	160	2
H. Shale	245	28
Med. Shale	285	31
shale	310	31
Thin Sand	318	34
Sand + sh	340	35
Sand shale	350	360

Information upon completion of well:

(1) Diameter 4 inches.

(2) Total Depth 360 feet.

(3) Water Level 147 feet below top of ground.

(4) Cased to 25', Size 4


(5) Screen: Size _____, Length _____

(6) Were any formations sealed against pollution?
 _____ yes, no.

If YES depth of formation _____

Why _____

Drillers Remarks: _____

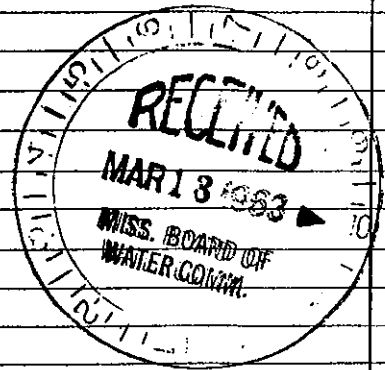

(Use Back Side)

Well N