

L AVO.

024

7-6-64

MISSISSIPPI BOARD OF WATER COMMISSIONERS

WATER WELL DRILLERS LOG

Date: 7-6-64, 1964, Driller: M. McDonald & Hill, Inc. County Lauderdale

(Name)

(1) Owner of Land: J. P. BONAR
(Name)

(Address)

19 EAST

(Address)

(2) Location: 1/4, 33 6 N 17 E, Sec. T R

7 miles EAST, of MERIDIAN
(distance) (direction) (Nearest Town)

(3) Topography: X
(Hilly) (Flat) (Level)

(4) Purpose of Well: DOMESTIC
(Domestic Irrigation
Municipal, Industrial, Other)

Description & Color of Materials
Sand, Clay, Red Clay, Shell, etc.

Thick-
ness
Feet

Depth
Feet

Description & Color of Materials Sand, Clay, Red Clay, Shell, etc.	Thick- ness Feet	Depth Feet
<u>CLAY</u>	<u>0</u>	<u>10</u>
<u>SANDY YELLOW CLAY</u>	<u>10</u>	<u>35</u>
<u>SHALE</u>	<u>35</u>	<u>120</u>
<u>SAND</u>	<u>120</u>	<u>135</u>
<u>SHALE</u>	<u>135</u>	<u>148</u>
<u>ROCK</u>	<u>148</u>	<u>150</u>
<u>SHALE</u>	<u>150</u>	<u>200</u>
<u>SANDY</u>	<u>200</u>	<u>228</u>
<u>SHALE</u>	<u>228</u>	<u>375</u>
<u>SAND</u>	<u>375</u>	<u>400</u>


Information upon completion of well:

- (1) Diameter 4" inches.
- (2) Total Depth 400' feet.
- (3) Water Level 175' feet below top of ground.
- (4) Cased to 250, Size 4"
- (5) Screen: Size _____, Length _____
- (6) Were any formations sealed against pollution?
_____ yes, _____ no.

If YES depth of formation _____

Why _____

Drillers Remarks: _____

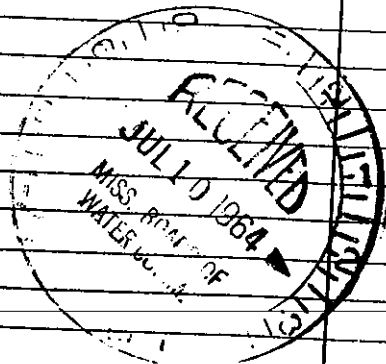

Well 1