


LAUD. MISSISSIPPI BOARD OF WATER COMMISSIONERS

025
1-2-62

WATER WELL DRILLERS LOG

Date: 1. 2, 1962, Driller: McDonald Hill County: Lauderdale

		Description & Color of Materials Sand, Clay, Red Clay, Shell, etc.	Thick- ness Feet	Depth Feet
(1) Owner of Land	JAMES TALBOTT (Name)	SAND CLAY	0	20
	R# 7 MERIDIAXI (Address)	SANDY SHALE	20	45
(2) Location:	1/4, 1/4, Sec. 33 6 N 17 E T R	SHALE	45	130
	7 miles EAST of MERIDIAXI (distance) (direction) (Nearest Town)	SANDY SHALE	130	200
(3) Topography:	Y (Hilly) (Flat) (Level)	SHALE	200	280
(4) Purpose of Well:	DOMESTIC (Domestic Irrigation Municipal, Industrial, Other)	SAND	280	300
Information upon completion of well:				
(1) Diameter	3" inches.			
(2) Total Depth	300' feet.			
(3) Water Level	160' feet below top of ground.			
(4) Cased to	231', Size 3"			
(5) Screen: Size	Length			
(6) Were any formations sealed against pollution?	yes, no.			
If YES depth of formation				
Why				
Drillers Remarks:				

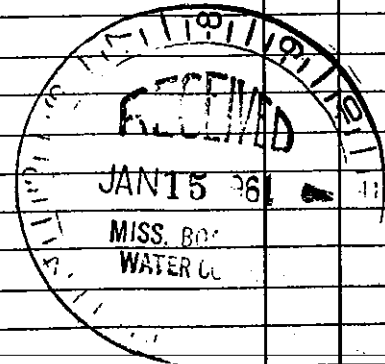

Well