

LAUD. MISSISSIPPI BOARD OF

027


WATER WELL DRILLERS LOG

9-9-64

Date: 9-9, 1964; Driller: M. E. Donald & Hill, Inc. County

(Name)

	Description & Color of Materials Sand, Clay, Red Clay, Shell, etc.	Thick- ness Feet	Depth Feet
(1) Owner of Land: <u>JAMEST ROLLINS</u> (Name)	SAND & CLAY	0	47
<u>Rt. # 7, Meridian, Miss</u> (Address)	SHALE	47	73
(2) Location: <u>1/4, 1/4, Sec. 34</u> T. R. <u>UNITE</u>	ROCK	73	75
<u>8</u> miles <u>East</u> of <u>Meridian</u> (distance) (direction) (Nearest Town)	FINE SAND	75	90
(3) Topography: <input checked="" type="checkbox"/> (Hilly) <input type="checkbox"/> (Flat) <input type="checkbox"/> (Level)	SHALE	90	140
(4) Purpose of Well: <u>Domestic</u> (Domestic, Irrigation, Municipal, Industrial, Other)	SANDY SHALE	140	170
Information upon completion of well:			
(1) Diameter <u>3 1/2</u> inches. <u>TEST HOLE</u>			
(2) Total Depth <u>170'</u> feet.			
(3) Water Level <u>37'</u> feet below top of ground.			
(4) Cased to <u>64'</u> , Size <u>4"</u>			
(5) Screen: Size _____, Length _____			
(6) Were any formations sealed against pollution? _____ yes, _____ no.			
If YES depth of formation _____			
Why _____			
Drillers Remarks: _____			

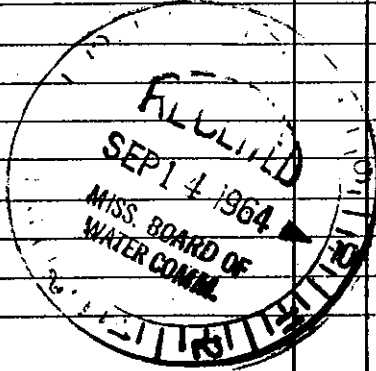

(Use Back Side)

Well No.

Mail this copy to Board of Water Commissioners 429 Miss. St. Jackson, Miss