


LAUD MISSISSIPPI BOARD OF WATER COMMISSIONERS

029
5-8-63

WATER WELL DRILLERS LOG

Date: 5-8-63, Driller: JAMES MATLOCK County: LAUDerdale
(Name)

(1) Owner of Land: <u>Mrs. AGNES PELEN</u> (Name)	Description & Color of Materials Sand, Clay, Red Clay, Shell, etc.	Thick- ness Feet	Depth Feet
<u>R#7 MERIDIAN</u> (Address)	<u>RED CLAY</u>	0	20
(2) Location: <u>1/4, 1/4, Sec. T R</u>	<u>SHALE ST. SAND</u>	20	122
<u>8</u> miles <u>EAST</u> of <u>MERIDIAN</u> (distance) (direction) (Nearest Town)	<u>SHALE</u>	120	165
(3) Topography: <u>X</u> (Hilly) (Flat) (Level)	<u>SHALE ST. SAND</u>	165	230
(4) Purpose of Well: <u>DOMESTIC</u> (Domestic Irrigation, Municipal, Industrial, Other)	<u>SHALE</u>	235	330
Information upon completion of well:	<u>SAND</u>	330	350
(1) Diameter <u>4"</u> inches.	<u>SANDY SHALE</u>	350	390
(2) Total Depth <u>390'</u> feet.			
(3) Water Level <u>205'</u> feet below top of ground.			
(4) Cased to <u>244'</u> , Size <u>4"</u>			
(5) Screen: Size _____, Length _____			
(6) Were any formations sealed against pollution? _____ yes, _____ no.			
If YES depth of formation _____			
Why _____			
Drillers Remarks: _____			

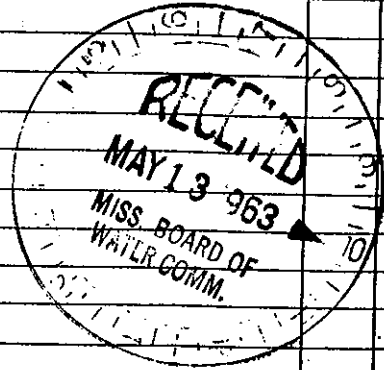

(Use Back Side)

Well No