

L.H.U.O.
 51
 7-15-60

MISSISSIPPI BOARD OF WATER COMMISSIONERS

WATER WELL DRILLERS LOG

20113
CODED

Date: 7-15-60, 1960, Driller: McDonald Hill County: Lumbardale
 (Name)

(1) Owner of Land: BARNHAM
 (Name)
R#5 Meridian
 (Address)

(2) Location: $\frac{1}{4}$, 30, $\frac{1}{4}$, Sec. 6 17
6 miles West, of Meridian
 (distance) (direction) (Nearest Town)

(3) Topography: X
 (Hilly) (Flat) (Level)

(4) Purpose of Well:
 (Domestic Irrigation
 Municipal, Industrial, Other)

Description & Color of Materials Sand, Clay, Red Clay, Shell, etc.	Thick- ness Feet	Depth Feet
Clay	0	10
Shale	10	20
Sandy Clay	28	34
Soft Shale	34	50
Med Shale	50	84
Sandy Shale	84	110
Soft Shale	110	145
Med Shale	145	170
Soft Shale	170	200
fine sand	200	205
Med Shale	205	215
fine sand	215	221
Sandy Shale	221	250

Information upon completion of well:


- (1) Diameter 3" inches.
- (2) Total Depth 250 feet.
- (3) Water Level 48' feet below top of ground.
- (4) Cased to 168', Size 3"
- (5) Screen: Size _____, Length _____
- (6) Were any formations sealed against pollution?
 _____ yes, X no.

If YES depth of formation _____

Why _____

Drillers Remarks: _____

CODED

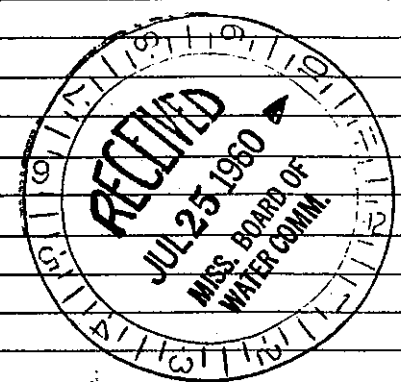

(Use Back Side)

Well No.

Mail this copy to Board of Water Commissioners 429 Miss. St. Jackson, Miss