

CODED

Φ53
8-22-60

WATER WELL DRILLERS LOG

Date: 8.22.60 1960, Driller McDonald Hill County Lauderdale
(Name)

		Description & Color of Materials Sand, Clay, Red Clay, Shell, etc.	Thick- ness Feet	Depth Feet
(1) Owner of Land: <u>Pita McInnis</u> (Name)				
<u>PH 6 Meridian</u> (Address)		<u>Clay</u>	<u>0</u>	<u>10</u>
(2) Location: <u>27 6 17</u> ¼, ¼, Sec. T R		<u>Sand</u>	<u>10</u>	<u>20</u>
<u>6</u> miles <u>East</u> of <u>Meridian</u> (distance) (direction) (Nearest Town)		<u>Med shale</u>	<u>20</u>	<u>162</u>
(3) Topography: <u>X</u> (Hilly) (Flat) (Level)		<u>Sandy Marl</u>	<u>162</u>	<u>170</u>
(4) Purpose of Well: <u>Domestic</u> (Domestic Irrigation Municipal, Industrial, Other)		<u>Soft marl</u>	<u>170</u>	<u>200</u>
		<u>Sandy marl</u>	<u>200</u>	<u>230</u>
		<u>Sand</u>	<u>230</u>	<u>233</u>
		<u>Sandy marl</u>	<u>233</u>	<u>240</u>

Information upon completion of well:


- (1) Diameter 3" inches.
- (2) Total Depth 240' feet.
- (3) Water Level 124' feet below top of ground.
- (4) Cased to 126', Size 3"
- (5) Screen: Size _____, Length _____
- (6) Were any formations sealed against pollution?
_____ yes, X no.

If YES depth of formation _____

Why _____

Drillers Remarks: _____

CODED

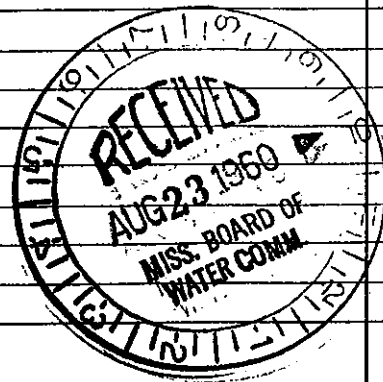

(Use Back Side)

Well No.

Mail this copy to Board of Water Commissioners 429 Miss. St. Jackson, Miss