

LAUD.

MISSISSIPPI BOARD OF WATER COMMISSIONERS

054

WATER WELL DRILLERS LOG

CODED

5-8-61

Date: 5-8, 1961, Driller: M. E. Donald & H. W. County Lauderdale

(Name)

(1) Owner of Land: Robert Lee Dean
(Name)
Rt #6
(Address)

(2) Location: 1/4, 1/4, Sec. 6 17
3 miles East, of Manly
(distance) (direction) (Nearest Town)

(3) Topography: (Hilly) (Flat) (Level)

(4) Purpose of Well: Domestic
(Domestic Irrigation
Municipal, Industrial, Other)

Description & Color of Materials Sand, Clay, Red Clay, Shell, etc.	Thick- ness Feet	Depth Feet
clay	0	12
Sandy clay	12	38
shale	38	45
clay	45	75
Soft shale	75	90
Sandy shale	90	155
med shale	155	175
Soft shale	175	225
med. shale	225	245
Soft shale	245	280
Sandy shale & sand	280	305
Sandy shale & st. lignite	305	337
Fine sand	332	352

Information upon completion of well:

(1) Diameter 3 inches.

(2) Total Depth 350 feet.

(3) Water Level 120 feet below top of ground.

(4) Cased to 338, Size 3"

(5) Screen: Size none, Length _____


(6) Were any formations sealed against pollution?
_____ yes, no.

If YES depth of formation _____

Why _____

Drillers Remarks: _____

CODED

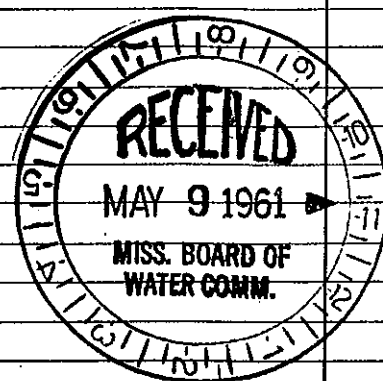

(Use Back Side)

Well No.

Mail this copy to Board of Water Commissioners 429 Miss. St. Jackson, Miss