

MISSISSIPPI BOARD OF WATER COMMISSIONERS

LAUD.
 55
 7-19-61
 Date: 7-19, 1961

WATER WELL DRILLERS LOG

CODED

Driller: Mr. C. Donald Hill County, Louisiana
 (Name)

(1) Owner of Land: Jessie Owenby
 (Name)
Rt. #5
 (Address)

(2) Location: 20 6 17
 1/4, 1/4, Sec. T R
5 miles East of Meridian
 (distance) (direction) (Nearest Town)

(3) Topography: (Hilly) (Flat) (Level)

(4) Purpose of Well: Domestic
 (Domestic Irrigation
 Municipal, Industrial, Other)

Description & Color of Materials Sand, Clay, Red Clay, Shell, etc.	Thick- ness Feet	Depth Feet
Clay	0	10
Sandy Clay	10	22
Shale	22	36
Sandy Shale	36	48
Shale	48	90
Sandy Shale	90	140

Information upon completion of well:

(1) Diameter 3 inches.

(2) Total Depth 140' feet.

(3) Water Level 42 feet below top of ground.

(4) Cased to 84, Size 3"


(5) Screen: Size None, Length _____

(6) Were any formations sealed against pollution?
 _____ yes, no.

If YES depth of formation _____

Why _____

Drillers Remarks: _____

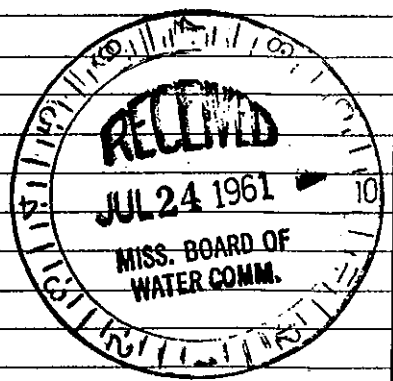

CODED

Mail this copy to Board of Water Commissioners 429 Miss. St. Jackson, Miss.

(Use Back Side)

Well No.