

LAUD.

MISSISSIPPI-BOARD OF WATER COMMISSIONERS

Ø 56
8-23-61

WATER WELL DRILLERS LOG

CODED

Date: 8.23, 19 61 Driller: McDonald, W. H. County: Lauderdale

(1) Owner of Land: REX HARRISON
(Name)
MERIDIAN R# 7
(Address)

(2) Location: ¼, 29 6 1/2 Sec.
17 miles S. East of Meridian
(distance) (direction) (nearest town)

(3) Topography: (Hilly) (Flat) (Level)

(4) Purpose of Well: Domestic
(Domestic, Irrigation, Municipal, Industrial, Other)

Description & Color of Materials Sand, Clay, Red Clay, Shell, etc.	Thick- ness Feet	Depth Feet
Clay	0	0
Sandy Clay	5	5
Clay	15	15
Shale	35	40
Clay	40	55
Broken Shale	55	60
Sandy Shale	60	72
Loam	72	101
Sandy Shale	105	114
Med Shale	114	130
Rock	130	140
Med Shale	140	200
Med Shale	200	220
Shale Lt lignite	220	240
Sandy shale Lt lignite	240	250
Shale	250	280
Sandy shale Lt lignite	280	290
Sandy shale	290	310

Information upon completion of well:

(1) Diameter 3 inches.

(2) Total Depth 310 feet.

(3) Water Level 160 feet below top of ground.

(4) Cased to 138, Size 3"

(5) Screen: Size _____, Length _____


(6) Were any formations sealed against pollution?
yes, no.

If YES depth of formation _____

Why _____

Drillers Remarks: _____

CODED

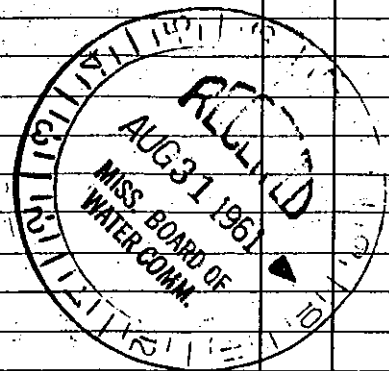

(Use Back Side)

Well No.

Mail this copy to Board of Water Commissioners 429 Miss. St. Jackson, Miss