

LAUD.

MISSISSIPPI BOARD OF WATER COMMISSIONERS

657
7-24-62

WATER WELL DRILLERS LOG

CODED

Date: 7-24, 1962, Driller: M^r Donald J Hill County lauderdale
(Name)

(1) Owner of Land: Felix Linton
(Name)
Rt # 6 Meridian, Miss.
(Address)

(2) Location: 1/4, 24 6 17
35
6 miles East of Meridian
(distance) (direction) (Nearest Town)

(3) Topography: _____
(Hilly) (Flat) (Level)

(4) Purpose of Well: Domestic
(Domestic Irrigation
Municipal, Industrial, Other)

Description & Color of Materials Sand, Clay, Red Clay, Shell, etc.	Thick- ness Feet	Depth Feet
Clay	0	10
Sand sh Clay	10	20
Clay	20	30
Shale	30	40
Rock	40	43
Soft Shale	43	60
Sand	60	70
Sandy Shale	70	82
Shale	82	153
Shale	153	245
Sandy Shale	245	260
Fine Sand	260	290
Sandy Shale	290	300

Information upon completion of well:

(1) Diameter 4 inches.

(2) Total Depth 300 feet.

(3) Water Level 190 feet below top of ground.

(4) Cased to 189, Size 4"

(5) Screen: Size _____, Length _____


(6) Were any formations sealed against pollution?
_____ yes, no.

If YES depth of formation _____

Why _____

Drillers Remarks: _____

CODED

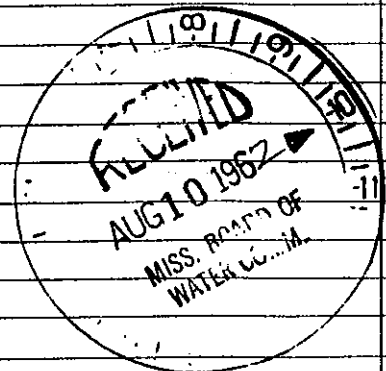

(Use Back Side)

Well No.

Mail this copy to Board of Water Commissioners 429 Miss. St. Jackson, Miss