

LAUD.
 059
 4-12-63

MISSISSIPPI BOARD OF WATER COMMISSIONERS

WATER WELL DRILLERS LOG

CODED

Date: 9-12, 1963, Driller: Mc Donald & Wife County Lauderdale
 (Name)


(1) Owner of Land: Billy Smith
 (Name)
 (Address) 5 6 17
 (2) Location: 1/4, 1/4, Sec. 6 T R
12 miles East, of Meridian
 (distance) (direction) (Nearest Town)
 (3) Topography: Hilly
 (Hilly) (Flat) (Level)
 (4) Purpose of Well: Domestic
 (Domestic Irrigation
 Municipal, Industrial, Other)

Description & Color of Materials Sand, Clay, Red Clay, Shell, etc.	Thick- ness Feet	Depth Feet
<u>Clay</u>	<u>0</u>	<u>15</u>
<u>sd. sdy clay</u>	<u>15</u>	<u>30</u>
<u>shale</u>	<u>30</u>	<u>58</u>
<u>Hard lime</u>	<u>58</u>	<u>61</u>
<u>sd. sdy shale</u>	<u>61</u>	<u>80</u>
<u>shale w/pebb. lignite</u>	<u>85</u>	<u>110</u>
<u>sd. shale</u>	<u>110</u>	<u>122</u>
<u>sd. shale w/pebb. st.</u>	<u>122</u>	<u>138</u>
<u># 3 sand</u>	<u>138</u>	<u>143</u>
<u>sd. shale w/pebb. st.</u>	<u>143</u>	<u>160</u>

Information upon completion of well:

(1) Diameter 3 7/8 inches.
 (2) Total Depth 360 feet.
 (3) Water Level 135 feet below top of ground.
 (4) Cased to 250, Size 4
 (5) Screen: Size _____, Length _____
 (6) Were any formations sealed against pollution?
 _____ yes, _____ no.
 If YES depth of formation _____
 Why _____
 Drillers Remarks: _____

CODED

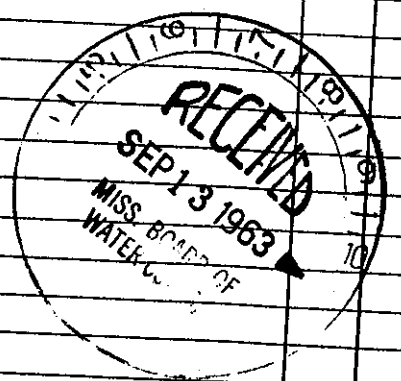

Well No.
108

Mail this copy to Board of Water Commissioners 429 Miss. St. Jackson, Miss. (Use Back Side)