

LAUD.

MISSISSIPPI BOARD OF WATER COMMISSIONERS

Φ61
1-13-64

WATER WELL DRILLERS LOG

CODED

Date: 1.13, 1964, Driller: McDONALD - HILL County
(Name)

(1) Owner of Land: Roy McRae Sr
(Name)
R#6 Meridian
(Address)

(2) Location: 1/4, 2d Sec. 6, 67
(distance) (direction) (Nearest Town)

(3) Topography: X
(Hilly) (Flat) (Level)

(4) Purpose of Well:
(Domestic Irrigation, Municipal, Industrial, Other)

Description & Color of Materials Sand, Clay, Red Clay, Shell, etc.	Thick- ness Feet	Depth Feet
CLAY	0	50
SHALE	50	70
SANDY CLAY	70	115
SHALE	115	130
SANDY CLAY	130	160
SAND	160	174
SHALE	174	360
SANDY SHALE	360	425
SAND	425	445
SHALE	445	465
FINE SAND	465	475
SANDY SHALE	475	507
ST SAND		

Information upon completion of well:


- (1) Diameter 4" inches.
- (2) Total Depth 507' feet.
- (3) Water Level 285 feet below top of ground.
- (4) Cased to 345, Size 4"
- (5) Screen: Size _____, Length _____.
- (6) Were any formations sealed against pollution?
_____ yes, _____ no.

If YES depth of formation _____

Why _____

Drillers Remarks: _____

CODED

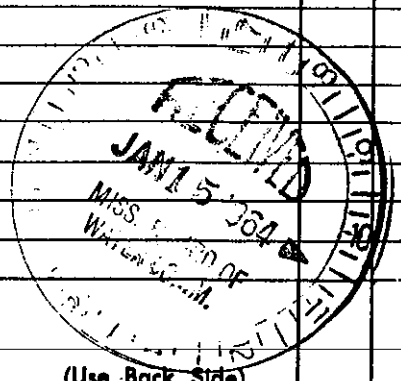

(Use Back Side)

Well No.

Mail this copy to Board of Water Commissioners 429 Miss. St. Jackson, Miss