

C.A.U.D.  
 063  
 6-16-64

MISSISSIPPI BOARD OF WATER COMMISSIONERS

WATER WELL DRILLERS LOG

**CODED**

Date: 6-16, 1964, Driller: M. E. Downhill & Hill, Inc. County Leflore  
(Name)

(1) Owner of Land	Description & Color of Materials <small>Sand, Clay, Red Clay, Shell, etc.</small>	Thick- ness Feet	Depth Feet
<u>MT GILEAD Proctor</u> <small>(Name)</small>			
<u>Mt #6, Meridian, Miss</u> <small>(Address)</small>	<u>CLAY</u>	<u>0</u>	<u>10</u>
	<u>SHALE</u>	<u>10</u>	<u>68</u>
	<u>SAND &amp; SHALE</u>	<u>68</u>	<u>118</u>

(2) Location: 1/4, 1/4, Sec. 7 & 17  
(distance) (direction) (Nearest Town)

4 miles East, of Meridian  
(distance) (direction) (Nearest Town)

(3) Topography:  (Hilly)  (Flat)  (Level)

(4) Purpose of Well: \_\_\_\_\_  
(Domestic Irrigation, Municipal, Industrial, Other)

Information upon completion of well:


- (1) Diameter 3 1/4 inches. TEST HOLE
- (2) Total Depth 118' feet.
- (3) Water Level 65' feet below top of ground.
- (4) Cased to 105, Size 2"
- (5) Screen: Size 2, Length 5' R.P. 455
- (6) Were any formations sealed against pollution?  
 \_\_\_\_\_ yes, \_\_\_\_\_ no.

If YES depth of formation \_\_\_\_\_

Why \_\_\_\_\_

Drillers Remarks: \_\_\_\_\_

**CODED**

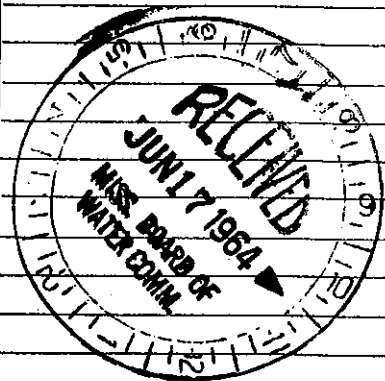

(Use Back Side)

Well No.

Mail this copy to Board of Water Commissioners 429 Miss. St. Jackson, Miss.