

LAUO.

MISSISSIPPI BOARD OF WATER COMMISSIONERS

064
6-29-64

WATER WELL DRILLERS LOG

CODED

Date: 6.29, 1964, Driller: M. Donald & H. H. Jr County Lauderdale
(Name)

(1) Owner of Land: CARL HARPER
(Name)
R#6 MERIDIAN
(Address)

(2) Location: 1/4, 1/4, Sec. 17 T. 17 R. 17
12 miles East of Meridian
(distance) (direction) (Nearest Town)

(3) Topography: (Hilly) (Flat) (Level)

(4) Purpose of Well: Domestic
(Domestic Irrigation, Municipal, Industrial, Other)

Description & Color of Materials Sand, Clay, Red Clay, Shell, etc.	Thick- ness Feet	Depth Feet
CLAY	0	10
SHALE	10	30
SAND	30	45
SHALE	45	260
SAND	260	285
SHALE	285	335
SHALE ST SAND	335	360
SHALE	360	400
SAND ST SHALE	400	500
SAND	500	515
SANDY	515	530

Information upon completion of well:

(1) Diameter 4" inches.


(2) Total Depth 530' feet.

(3) Water Level 245' feet below top of ground.


(4) Cased to 291', Size 4"

(5) Screen: Size 2, Length 8' STEEL
2 40' 2" PIPE

(6) Were any formations sealed against pollution?
1
_____ yes, _____ no.

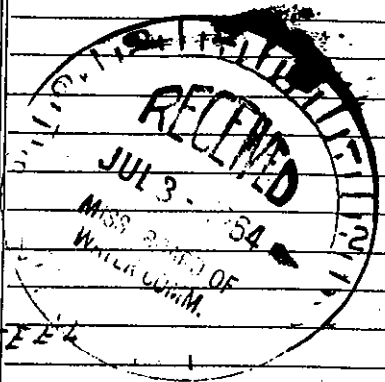

CODED

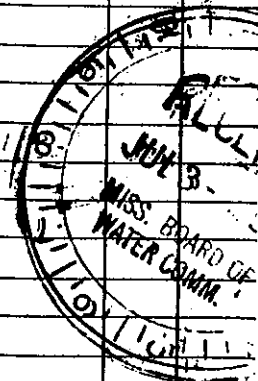

If YES depth of formation _____

Why _____

Drillers Remarks: _____

(Use Back Side)

Well No.

Mail this copy to Board of Water Commissioners 429 Miss. St. Jackson, Miss