

LAUD.
 066
 7-20-64

WATER WELL DRILLERS LOG

CODED

Date: 7-20-64, 1964, Driller: M. J. Donald & Hill, Jr. County Montgomery


(1) Owner of Land: Mt. Gilead Petroleum
 (Name)
Rt. #6, Meridian, Miss
 (Address)

(2) Location: 1/4, 1/4 Sec. 6 17
8 miles EAST of Meridian
 (distance) (direction) (Nearest Town)

(3) Topography: (Hilly) (Flat) (Level)

(4) Purpose of Well: _____
 (Domestic Irrigation, Municipal, Industrial, Other)

Description & Color of Materials Sand, Clay, Red Clay, Shell, etc.	Thick- ness Feet	Depth Feet
CLAY	0	10
SHALE	10	60
SANDY	60	68
SAND	68	100
SHALE	120	147
SAND	147	155
SHALE	155	210
SANDY	210	225

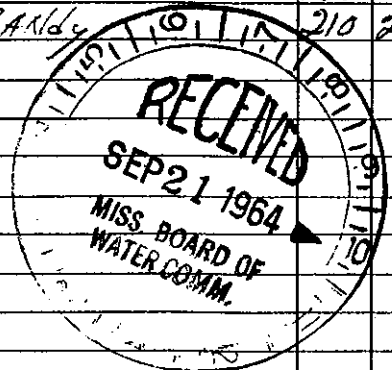

CODED

Information upon completion of well:

(1) Diameter 3 7/8 inches. TEST HOLE

(2) Total Depth 226' feet.

(3) Water Level 147' feet below top of ground.

(4) Cased to 126', Size 4"
108" 2"

(5) Screen: Size _____, Length _____
1 = 4 x 2 1/2 BUSHING

(6) Were any formations sealed against pollution?
1 = 2" CYLINDER
 yes, _____ no, _____
1 = 2" COUPLING

If YES depth of formation _____

Why _____

Drillers Remarks: _____

Retain this copy for your office files.

(Use Back Side)

Well No.