

LAND.

... AND OF WATER ...

Φ68

# WATER WELL DRILLERS LOG

# CODED

11-11-64

Date: 11/11, 1964, Driller: M. McDonald & Hill Inc

Landen Lake

(Name)

(1) Owner of Land: MARTIN SCOTT  
(Name)

MERIDIAN R# 5  
(Address)

(2) Location: 1/4, 6, Sec. 17, T. R  
(distance) (direction) (Nearest Town)

5 miles East of Meridian  
(distance) (direction) (Nearest Town)

(3) Topography: X  
(Hilly) (Flat) (Level)

(4) Purpose of Well: DOMESTIC  
(Domestic Irrigation, Municipal, Industrial, Other)

Description & Color of Materials Sand, Clay, Red Clay, Shell, etc.	Thick- ness Feet	Depth Feet
CLAY	0	10
SHALE	10	80
SAND	80	118
SHALE	118	230
SANDY SHALE ST SAND	230	260

### Information upon completion of well:

(1) Diameter 4" WELL inches.

(2) Total Depth 260' feet.

(3) Water Level 38' feet below top of ground.

(4) Cased to 126', Size 4" BLACK

(5) Screen: Size \_\_\_\_\_, Length \_\_\_\_\_


(6) Were any formations sealed against pollution?  
\_\_\_\_\_ yes, \_\_\_\_\_ no.

If YES depth of formation \_\_\_\_\_

Why \_\_\_\_\_

Drillers Remarks: \_\_\_\_\_

# CODED

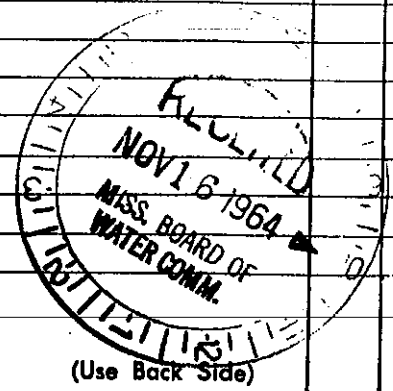

(Use Back Side)

Well No.

Mail this copy to Board of Water Commissioners 429 Miss. St. Jackson, Miss.