

LAUD.
#69
1-15-65

MISSISSIPPI BOARD OF WATER COMMISSIONERS

WATER WELL DRILLERS LOG

CODED

Date: 1-15, 1965, Driller: SCARBROUGH County LAUD
(Name)

(1) Owner of Land: <u>MRS SHOEMAKER</u> (Name)	Description & Color of Materials Sand, Clay, Red Clay, Shell, etc.	Thick- ness Feet	Depth Feet
<u>RT 5</u> (Address) <u>MDN</u>			
(2) Location: <u>1/4</u> , <u>20</u> Sec. <u>6</u> , T. <u>17</u> <u>9</u> miles <u>W</u> , of <u>MDN</u> (distance) (direction) (Nearest Town)	<u>yellow clay</u>	<u>12'</u>	<u>12'</u>
(3) Topography: <input checked="" type="checkbox"/> (Hilly) <input type="checkbox"/> (Flat) <input type="checkbox"/> (Level)	<u>light sand & clay</u>	<u>40</u>	<u>52'</u>
(4) Purpose of Well: <u>Domestic</u> (Domestic Irrigation Municipal, Industrial, Other)	<u>blue clay</u>	<u>100</u>	<u>152</u>
	<u>sand & shale streaks</u>	<u>100</u>	<u>252</u>
	<u>(Road mark 252)</u>		

Information upon completion of well:

(1) Diameter 4 inches.

(2) Total Depth 251 feet.

(3) Water Level 29 feet below top of ground.

(4) Cased to 129, Size 4"

(5) Screen: Size No, Length _____


(6) Were any formations sealed against pollution?
_____ yes, no.

If YES depth of formation _____

Why _____

Drillers Remarks: _____

CODED

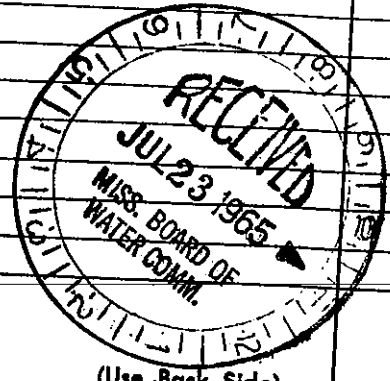

Well No.

Mail this copy to Board of Water Commissioners 429 Miss. St. Jackson, Missa

(Use Back Side)