


Lauderdale
 Ø 120
 10-13-75

MISSISSIPPI
 BOARD OF WATER COMMISSIONERS
 416 North State Street
 Jackson, Mississippi 39201

WATER WELL DRILLERS LOG

10.13.75 19 ^{13P} McDonald + Hill Lauderdale
 date well completed firm name county well located

LANDOWNER:	description of formations encountered	from	to
JOHNNIE BOOKER	Clay sand	0	52
14-#6, mendon, miss (mailing address)	shale	52	107
WELL LOCATION: sec. 33 T-6N R-17E 1/2 miles EAST of VINNIVILLE (distance) (direction) (nearest town)	sandy shale	107	112
WELL PURPOSE: (home, irrigation, municipal, industrial)	shale	112	128
WELL COMPLETION DATA: (1) diameter (inches) 4"	sandy shale	128	134
(2) total depth (feet) 240	shale	134	170
(3) static water level (feet) 115' below top of ground.	sandy shale	170	180
(4) casing PVC 152' (material) (depth) 4" (size) if telescope see back.	shale	180	220
(5) screen (length) (depth to top) (size) (material)	fine sand	220	240
(6) pump 1/2 HP 8 (HP) (yield gpm) E (type power)			
(7) electric log (yes or no) (organization running log)			
(8) how well bottom plugged OPEN			
DRILLERS REMARKS:			

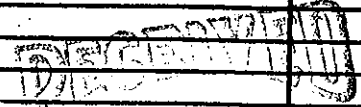

OCT 20 1975

MISS. BD. OF WATER COMM.