

(075)

STATE WELL REPORT

Part 1

Driller's Log

Mississippi Department of Environmental Quality
Office of Land and Water Resources
P.O. Box 2309
Jackson, MS 39225-2309
(601)961-5210
(601)360-0535 (fax)

For Office Use Only:

Well #: 0134
Aquifer: _____
E-Log #: _____

County: Lauderdale
Permit #: _____
Driller: _____
Date drilling completed: _____

State Law requires that this report be prepared by the license holder responsible for the work and filed with the Department at the above address within 30 days of completion of drilling of the well or borehole.

Well Owner Information (Landowner if borehole is not for a water well) Owner Name: <u>Al Harper / Senda West</u> Mailing Address: <u>601-696-4312</u> <u>267 Murphy Rd</u> <u>Meridian</u> <u>Ms.</u> <u>39307</u> City State Zip Code <u>Senda West</u> Telephone No. <u>(972) 210-1609</u>	Well or Borehole Location <u>88° 36' 19.08"</u> Latitude: <u>N32° 23.509'</u> Longitude: <u>W88° 36.320'</u> Method of Lat/Long (check one): Conventional Survey _____ USGS quad _____, Hand-held GPS _____, Survey-grade GPS _____ <u>NW 1/4 SW 1/4, Sec 6 T6N R17E</u> <u>10</u> Miles <u>East</u> of <u>Meridian, Ms.</u> (Distance) (Direction) (Nearest Town)
---	---

Well / Borehole Data

Date drilling started: 10/7/14 Date drilling completed: 10/8/14 Hole depth: 443 Hole diameter: 4"

Location of the source of any surface water used for drilling: _____

Method of dosing and volume of Chlorine used in drilling and development: 1/2 gal / 1000 gal

Logs run (circle all applicable): No log run Electric Gamma Ray Density Sonic Neutron Other: _____

Name of organization running log(s): _____

Purpose of borehole (circle one): Water Well Geotechnical/Geological Investigation Ground Source Heat Pump
 Seismic Survey Other (describe) _____

If drilling is not related to water well construction, skip the remainder of this block

Purpose of Well (circle all applicable): Home Industrial Public Supply Irrigation Fish Culture

Other (describe): _____

If a flowing well, method of flow regulation: Valve _____ Other (describe) _____

Static Water Level: 100 feet [above or below] land surface Date measured: _____
(circle one)

Method of measurement (circle one): Steel tape Electric tape Air line Other (describe): _____

Well depth: 443 Well grouted to a depth of: 20 feet Type of grout (circle one): Neat Cement Bentonite Mix

Casing length: 263 feet Casing diameter: 4" inches Type of casing: PVC

Screen length: 80 feet Screen diameter: 2 inches Type of screen: PVC

Screen slot size: .020 inches Setting depth: From 363 feet to 443 feet

Type of completion (circle all applicable): Gravel packed Underreamed Open hole Natural Development

Other (describe): _____

Top of lap pipe or reduction in casing: 263 feet

If telescoped or more than one screen, describe on next page

RECEIVED

NOV 12 2014

Form: OLWR-SWR-1A (4/13)

11.0053


11.3418

County: _____
 Permit #: _____

For Office Use Only:
 Well #: 030

The sketch below only required for water wells
If well telescopes, show depths on sketch.

Description of formations encountered must be provided for all wells and boreholes, unless specifically exempted by regulations

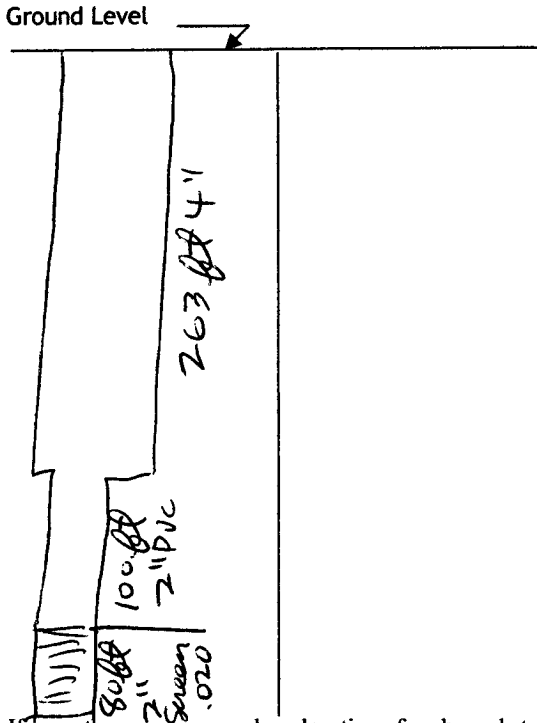

Description of Formations Encountered	From (depth)	To (depth)
	Ground level	
Top Clay	0	6
Thin Clay	6	108
Sand	108	112
Clay	112	263
Clay + Rock	263	363
Thin Sand + Clay layered	363	443

If more than one screen, show location of each on sketch

- Sketch the property layout and include the following:
- 1) the well location
 - 2) any permanent structures on the property that may aid in locating the well
 - 3) any roads, power lines, or other items that may aid in locating the property and the well
 - 4) north arrow

267 Murphy Rd.
 Meridian Ms.

RECEIVED
 NOV 12 2014
 BY: OLWR

Landowner Name: Al Harper

I HEREBY CERTIFY that the well/borehole was drilled, constructed, and completed in accordance with all applicable requirements of the Mississippi Department of Environmental Quality and the Mississippi Department of Health regulations, if applicable, and state laws.

THOMAS B. WILLIS 11/2/14 Thomas B. Willis #10627
 Print Name of Responsible Licensee and License No. Date Signature of Licensee

STATE WELL REPORT

Part 2

Pump Installer's Completion Report
 Mississippi Department of Environmental Quality
 Office of Land and Water Resources
 P.O. Box 2309
 Jackson, MS 39225-2309
 (601)961-5210
 (601) 360-0535 (fax)

For Office Use Only:

Well #: 030
 Aquifer: _____

County: _____
 Permit #: _____
 Driller: _____
 Date completed: _____
Copy information from block on Part 1

This part of the report must be completed by a licensed water well contractor or a licensed pump installer. A copy of Part 1 of the report must be attached and both parts filed with the Department at the above address within 30 days of well completion.

Well Owner Information	Well Location
Owner Name: <u>Al Harper</u>	Latitude: <u>N32°23.509</u> Longitude: <u>W88°36.320</u>
Mailing Address: <u>267 Murphy Rd</u>	Method of Lat/Long (check one): Conventional Survey _____, USGS quad _____, Hand-held GPS <u>X</u> , Survey-grade GPS _____
<u>Meridian</u> <u>Ms.</u> <u>39307</u>	<u>NW</u> ¼ <u>SW</u> ¼, Sec <u>6</u> T <u>6N</u> R <u>17E</u>
City State Zip Code	<u>10</u> Miles <u>SW</u> of <u>Meridian Ms.</u>
Telephone No. <u>(972) 210-1609</u>	(Distance) (Direction) (Nearest Town)

Pump Type (circle one)

Submersible Turbine Air Lift Centrifugal Flowing Well Jet Piston Rotary Other (describe): _____

Date Pump Installed: 10/8/14 Rated Pump Capacity: 10 Gallons Per Minute

Is This Pump (circle one): New Repaired Replacement

Power Type (circle one)

Electric Diesel Gasoline Natural Gas Tractor PTO Windmill Other (describe): _____

Horse Power Rating of Motor: 3/4 Setting Depth: 160 feet Number of Stages: 8

Pump Test Data for Non Flowing Well

Date Well Tested: _____ Duration of Pump Test (minimum 4 hours): _____ hours

Static Water Level (A): _____ Feet Below Land Surface Pumping Water Level (B): _____ Feet Below Land Surface

Drawdown [(B) - (A)]: _____ Feet Below Land Surface Test Pumping Rate: _____ Gallons Per Minute

Method of measurement (circle one): Steel tape Electric tape Air line Other (describe): _____

Pump Test Data for Flowing Well

Measured shut in head: _____ feet.

Well yielded _____ GPM with a drawdown of _____ feet after _____ hours of pumping

Meter Installation

Meter Manufacturer: _____ Meter Serial Number: _____

Meter Model Number/Name: _____ Type of Meter: _____

Totalizer Register Unit and Multiplier Factor (AF x .001, gal x 1000, etc): _____

Installation Date: _____ Meter installed by: _____

Is This Meter (circle one): New Repaired Replacement

Important: By submitting the above information you are certifying that this meter was installed to manufacturer standards. For agricultural wells, a list of approved meters is on the MDEQ website.

I HEREBY CERTIFY that the above statements are true to the best of my knowledge.

Thomas B. Willis 11/2/14 Thomas B. Willis
 Print Name of Pump Installer and License No. (if applicable) Date Signature of Pump Installer

RECEIVED

NOV 12 2014