

LAUDERDALE
 02000
 5-30-75

MISSISSIPPI
 BOARD OF WATER COMMISSIONERS
 416 North State Street
 Jackson, Mississippi 39201

WATER WELL DRILLERS LOG

5-30-1975 date well completed
 Jerry Drilling & Land firm name
 county well located

LANDOWNER:

Jerry Eubanks
 Rt 7, Mdn, Miss.
 (mailing address)

description of formations encountered

description of formations encountered	from	to
yellow clay	0	30
1" sand	30	50
clay	50	110
hard clay	110	240
clay	240	340
sand streaks	340	420

WELL LOCATION:

sec. 17 T. 6 N. R. 17 E.
 5 miles E of Mdn.
 (distance) (direction) (nearest town)

WELL PURPOSE:

(home, irrigation, municipal, industrial)

WELL COMPLETION DATA:


- diameter (inches) 4"
- total depth (feet) 420'
- static water level (feet) 260' below top of ground.
- casing PVC 300' (material), (depth)
 (size) if telescope see back.
- screen (length) (depth to top)
 (size) (material)
- pump 3/4 (HP) 5 (yield gpm)
 sub (type power)
- electric log (yes or no)

(organization running log)

(8) how well bottom plugged
 open

DRILLERS REMARKS:

good water

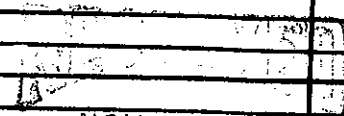

NOV 10 1975

MISS. BD. OF WATER COMM