


LAUDERDALE
 Ø 2004
 1-21-76

MISSISSIPPI
 BOARD OF WATER COMMISSIONERS
 416 North State Street
 Jackson, Mississippi 39201

WATER WELL DRILLERS LOG

1-21-76 19 MCDONALD + HILL LAUDERDALE
 date well completed firm name county well located

LANDOWNER:	description of formations encountered	from	to
JAMES HOLMES	CLAY	0	10
VIMVILLE (mailing address)	SHALE	10	22
WELL LOCATION: sec. 28 T. 6N R. 17E VIMVILLE (distance) miles (direction) of (nearest town)	SANDY ST SHALE	22	62
	SHALE	62	110
WELL PURPOSE: HOME (home, irrigation, municipal, industrial)	FINE SAND	110	120
WELL COMPLETION DATA:	SHALE	120	150
(1) diameter (inches) 4"	LIGNITE	150	152
(2) total depth (feet) 310	SAND	152	160
(3) static water level (feet) 135' below top of ground.	SOFT SHALE	160	195
(4) casing PVC 200' (material) (depth) 4" (size) if telescope see back.	SHALE	195	275
(5) screen (length) (depth to top)	SAND	275	310
(6) pump 1/2 SUB 6 (HP) (yield gpm) E (type power)			
(7) electric log (yes or no)			
(8) how well bottom plugged OPEN			
DRILLERS REMARKS:			

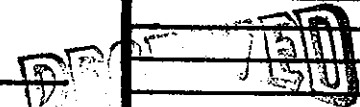

JAN 23 1976

MISS. BOARD OF WATER COMM.