

LAUDERDALE  
D 2043

MISSISSIPPI  
BOARD OF WATER COMMISSIONERS  
416 North State Street  
Jackson, Mississippi 39201

5-16-80  
5/16/80 19

WATER WELL DRILLERS LOG

Jerry Drilling Co. Land  
firm name county well located


LANDOWNER:  
Bill Temple  
Rt 10, Meridian, Miss.  
(mailing address)

description of formations encountered	from	to
Yellow Clay	0	30
Sand + Clay	30	65
Clay	65	270
Sand	270	300
Clay	300	340
Sand	340	375

WELL LOCATION:  
sec. 13 T 6 N R 17 E  
S W  
12 miles SE of Mer.  
(distance) (direction) (nearest town)

WELL PURPOSE:  
(Home, Irrigation, municipal, Industrial)

- WELL COMPLETION DATA:
- (1) diameter (inches) 4"
  - (2) total depth (feet) 375
  - (3) static water level (feet) 200 below above top of ground.
  - (4) casing PVC 335 (material) (depth) if telescope see back. (size)
  - (5) screen (length) (depth to top) (size) (material)
  - (6) pump 3/4 6 (HP) (yield gpm) Sub (type power)
  - (7) electric log (yes or no) (organization running log)
  - (8) how well bottom plugged open

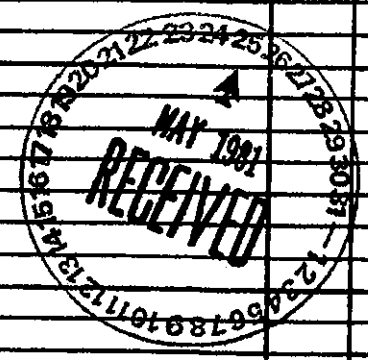

DRILLERS REMARKS: