

Lauderdale
Q 2014
6/25/80
 date well completed

MISSISSIPPI
 BOARD OF WATER COMMISSIONERS
 416 North State Street
 Jackson, Mississippi 39201

WATER WELL DRILLERS LOG

19 Long Drilling Co. firm name
Laud county well located

LANDOWNER:
Jeff Aiken
Rt 10, Mad. Miss.
 (mailing address)


description of formations encountered	from	to
<u>Yellow Clay</u>	<u>0</u>	<u>40</u>
<u>Sandy</u>	<u>40</u>	<u>85</u>
<u>Clay</u>	<u>85</u>	<u>300</u>
<u>Sandy</u>	<u>300</u>	<u>350</u>
<u>Clay</u>	<u>350</u>	<u>420</u>
<u>Sand</u>	<u>420</u>	<u>465</u>

WELL LOCATION:
 sec. 5 T 6 N R 17 E
 S W
1 miles S of Russell
 (distance) (direction) (nearest town)

WELL PURPOSE:
 (home) irrigation, municipal, industrial

- WELL COMPLETION DATA:
- (1) diameter (inches) 4"
 - (2) total depth (feet) 465
 - (3) static water level (feet) 320 below above top of ground
 - (4) casing Pvc 400
 (material) (depth)
 _____ if telescope see back.
 (size)
 - (5) screen _____
 (length) (depth to top)
 (size) (material)
 - (6) pump 3/4 6
 (HP) (yield gpm)
Sub
 (type power)
 - (7) electric log _____
 (yes or no)

 (organization running log)
 - (8) how well bottom plugged open

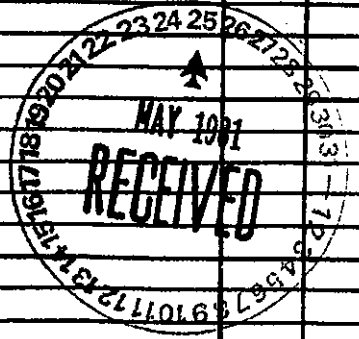

DRILLERS REMARKS: