


MISSISSIPPI BOARD OF WATER COMMISSIONERS

WATER WELL DRILLERS LOG

LAUD.
*PI
8-7-61

Date: 8/7, 1961, Driller: McDonald + Hill County Lauderdale
(Name)

	Description & Color of Materials Sand, Clay, Red Clay, Shell, etc.	Thick- ness Feet	Depth Feet
(1) Owner of Land: <u>Mrs. Conn</u> (Name)	Clay	0	16
<u>Tosonuba miss</u> (Address)	marl	16	18
(2) Location: <u>1/4</u> , <u>1/4</u> , Sec. <u>T</u> R. <u>R</u>	Sandy	18	33
<u>2</u> miles <u>South</u> of <u>Hudson</u> (distance) (direction) (Nearest Town)	marl	33	56
(3) Topography: _____ (Hilly) (Flat) (Level)	fine sand	56	67
(4) Purpose of Well: _____ (Domestic Irrigation Municipal, Industrial, Other)	soft marl	67	80
Information upon completion of well:	hard marl	80	90
(1) Diameter <u>2</u> inches.	soft marl	90	110
(2) Total Depth <u>200</u> feet.	hard marl	110	125
(3) Water Level <u>70</u> feet below top of ground.	sand + pebbles	125	136
(4) Cased to <u>189</u> , Size <u>2"</u>	sandy marl	136	140
(5) Screen: Size <u>2"</u> , Length <u>5 ft</u>	medium sand	140	146
(6) Were any formations sealed against pollution? _____ yes, <input checked="" type="checkbox"/> no.	soft brown marl	146	160
If YES depth of formation _____	sand + marl str.	160	175
Why _____	sand (good)	175	200
Drillers Remarks: _____			

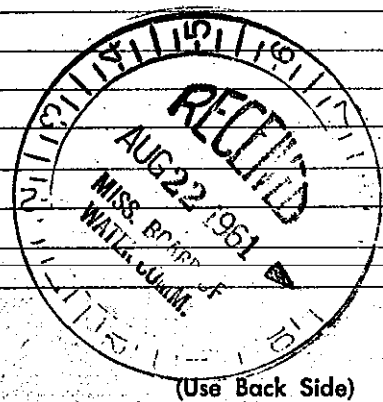

Well No.