

COMMISSIONERS

### WATER WELL DRILLERS LOG

LAND.

Date: 8-14-62, 1962, Driller: McDonald & Hice, Laurel Miss.  
(Name)

(1) Owner of Land: J.W. Shelby  
(Name)  
Rt 1 Tomnuba  
(Address)

(2) Location: 3 miles South E of Tomnuba  
(distance) (direction) (Nearest Town)

(3) Topography:  (Hilly)  (Flat)  (Level)

(4) Purpose of Well: Domestic  
(Domestic Irrigation, Municipal, Industrial, Other)

Description & Color of Materials Sand, Clay, Red Clay, Shell, etc.	Thick- ness Feet	Depth Feet
Clay	0	36
H Shale	36	70
M Shale	70	105
H Shale	105	127
Brown Shale	127	140
M Sand	140	164
Shale sand	164	170
Shale	170	197
C Sand	197	205
Shale	205	217
Soft shale	217	242
C Sand	242	270
F Sand	270	280

#### Information upon completion of well:

(1) Diameter 2 inches.

(2) Total Depth 280 feet.

(3) Water Level 160 feet below top of ground.

(4) Cased to 260, Size 2"


(5) Screen: Size 2", Length 5

(6) Were any formations sealed against pollution?  
 yes,  no.

If YES depth of formation \_\_\_\_\_

Why \_\_\_\_\_

Drillers Remarks: \_\_\_\_\_

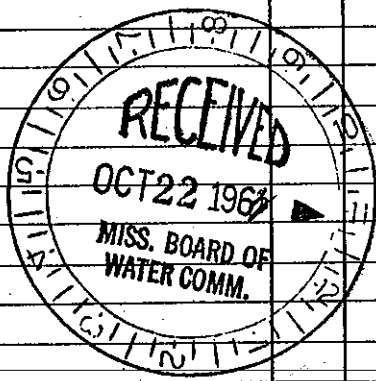

(Use Back Side)

Well No.

Mail this copy to Board of Water Commissioners 429 Miss. St. Jackson, Miss.