

LAUD. MISSISSIPPI BOARD OF WATER COMMISSIONERS

P3

12-13-65 WATER WELL DRILLERS LOG

Date: 12/13, 1965, Driller: TERRY County LAud
 (Name)


(1) Owner of Land: JAMES REYNOLDS
 (Name)
RT6 MERIDIAN
 (Address)
 (2) Location: 1/4, 1/4, Sec. 11 6N 18E T. R.
16 miles E of MDN.
 (distance) (direction) (Nearest Town)
 (3) Topography: (Level)
 (4) Purpose of Well: DOMESTIC
 (Domestic Irrigation, Municipal, Industrial, Other)

Description & Color of Materials Sand, Clay, Red Clay, Shell, etc.	Thick- ness Feet	Depth Feet
<u>YELLOW SAND & CLAY</u>	<u>0</u>	<u>65</u>
<u>SHALE</u>	<u>65</u>	<u>145</u>
<u>SAND</u>	<u>145</u>	<u>200</u>
<u>SHALE</u>	<u>200</u>	<u>365</u>
<u>SAND</u>	<u>365</u>	<u>375</u>
<u>HARD SHALE</u>	<u>375</u>	<u>470</u>
<u>SAND & SHALE</u>	<u>470</u>	<u>560</u>

Information upon completion of well:

(1) Diameter 4 inches.
 (2) Total Depth 560 feet.
 (3) Water Level 240' feet below top of ground.
 (4) Cased to 384, Size 4
 (5) Screen: Size NO, Length _____
 (6) Were any formations sealed against pollution?
 _____ yes, _____ no.

If YES depth of formation _____
 Why _____
 Drillers Remarks: Good WATER

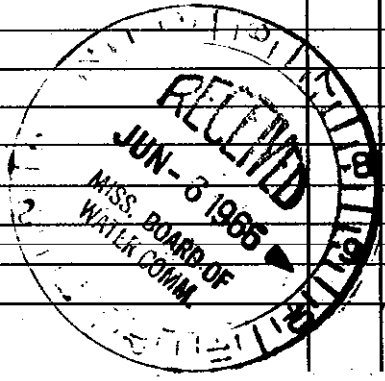

Well