

WATER COMMISSIONERS

LAUD.
P4

WATER WELL DRILLERS LOG


Date: 1/11, 1966, Driller: Zerry Spilling
SCARBROUGH County Laud
(Name)

(1) Owner of Land: <u>RAYMOND HARPER</u> (Name)	Description & Color of Materials Sand, Clay, Red Clay, Shell, etc.	Thick- ness Feet	Depth Feet
<u>RT 6, MERIDIAN MISS.</u> (Address)	<u>yellow sand a clay</u>	<u>0</u>	<u>66</u>
(2) Location: <u>1/4, 1/4, Sec. 11</u> <u>60186</u> <u>T R</u> <u>16</u> miles <u>EAST</u> of <u>MDN.</u> (distance) (direction) (Nearest Town)	<u>GRAY sand + shale</u>	<u>66</u>	<u>220</u>
	<u>SAND</u>	<u>220</u>	<u>285</u>
	<u>Shale</u>	<u>285</u>	<u>360</u>
	<u>SANDY</u>	<u>360</u>	<u>446</u>
(3) Topography: <input checked="" type="checkbox"/> (Hilly) <input type="checkbox"/> (Flat) <input type="checkbox"/> (Level)			
(4) Purpose of Well: <u>DOMESTIC</u> (Domestic Irrigation Municipal, Industrial, Other)			

Information upon completion of well:

- (1) Diameter 4 inches.
- (2) Total Depth 446 feet.
- (3) Water Level 265' feet below top of ground.
- (4) Cased to 338, Size 4.
- (5) Screen: Size 2", Length 10'.
- (6) Were any formations sealed against pollution?
_____ yes, _____ no.

If YES depth of formation _____
Why _____
Drillers Remarks: Good WATER

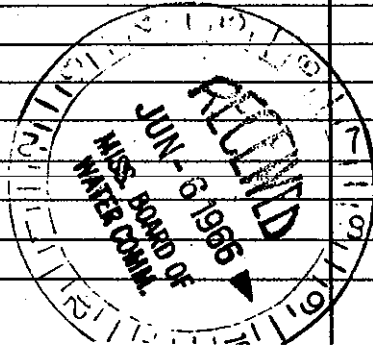

Well