

LAUDERDALE
 P 12
 3-67

MISSISSIPPI
 BOARD OF WATER COMMISSIONERS
 416 North State Street
 Jackson, Mississippi 39201

CODED

WATER WELL DRILLERS LOG

date well completed 19 MCDONALD HILL firm name LAUDERDALE county well located

LANDOWNER: SHADE SHELBY
TOANSCHA MISS
RT #1
 (mailing address)

WELL LOCATION:
 sec 6 T 6N R 18E
2 miles SOUTH of TOANSCHA
 (distance) (direction) (nearest town)


WELL PURPOSE: HOME
 (home, irrigation, municipal, industrial)

WELL COMPLETION DATA:

- (1) diameter (inches) 4" WELL
- (2) total depth (feet) 280'
- (3) static water level (feet) 82' below above top of ground.
- (4) casing 4" PVC 200'
 (material) (depth)
4" If telescope see back.
 (size)
- (5) screen 6' 274'
 (length) (depth to top)
2" PVC
 (size) (material)
- (6) pump 3/8 12
 (HP) (yield gpm)
220
 (type power)
- (7) electric log NO
 (yes or no)
NO
 (organization running log)
- (8) how well bottom plugged VALUE

description of formations encountered	from	to
<u>clay ft sand</u>	<u>0</u>	<u>30</u>
<u>shale</u>	<u>30</u>	<u>50</u>
<u>shale</u>	<u>50</u>	<u>82</u>
<u>shale</u>	<u>82</u>	<u>144</u>
<u>fine sand</u>	<u>144</u>	<u>175</u>
<u>shale</u>	<u>175</u>	<u>204</u>
<u>fine sand</u>	<u>204</u>	<u>240</u>
<u>sand</u>	<u>240</u>	<u>280</u>

CODED

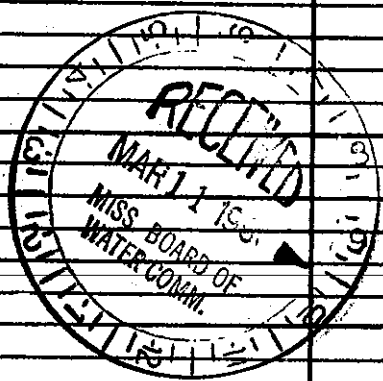

DRILLERS REMARKS: