

AUDERDALE
P 24
2-21-74

MISSISSIPPI
 BOARD OF WATER COMMISSIONERS **CODED**
 416 North State Street
 Jackson, Mississippi 39201

WATER WELL DRILLERS LOG

2-21-74 19 MCDONALD HILL LAUDERDALE
 date well completed firm name county well located

LANDOWNER:
EDDIE BROWN
R#1 TOOKS LbA
 (mailing address)

description of formations encountered	from	to
CLAY	0	12
SAND	12	40
SHALE	40	95
SAND	95	120
SHALE	120	

WELL LOCATION:
 sec. 2 T 6 N R 18 E
3 miles SOUTH KEWAHAWEE
 (distance) (direction) (nearest town)

CODED

WELL PURPOSE: HOME
 (home, irrigation, municipal, industrial)

WELL COMPLETION DATA:

(1) diameter (inches) 2"

(2) total depth (feet) 120

(3) static water level (feet) 13' below top of ground.

(4) casing PVC, 114'
 (material) (depth)
2" if telescope see back.
 (size)


(5) screen 6', 114'
 (length) (depth to top)
2", PVC
 (size) (material)

(6) pump 1/2 JET, 6
 (HP) (yield gpm)
ELECTRIC
 (type power)

(7) electric log _____
 (yes or no)

 (organization running log)

(8) how well bottom plugged VALVE

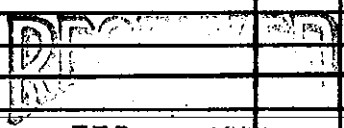

FEB 23 1974

DRILLERS REMARKS: