

LAUD. MISSISSIPPI BOARD OF WATER COMMISSIONERS

Q2
6-10-65

WATER WELL DRILLERS LOG

Date: 6-10, 1965, Driller: McDONALD & Hill, Inc. County: Madison
(Name)

(1) Owner of Land: Jim Johnson
(Name)
Chuck, Miss.
(Address)

(2) Location: 1/4, 1/4, Sec. 18 ^{SW NE} T R
5 miles S.E. of Chucky
(distance) (direction) (Nearest Town)

(3) Topography: (Hilly) (Flat) (Level)

(4) Purpose of Well: Domestic
(Domestic Irrigation, Municipal, Industrial, Other)

Description & Color of Materials Sand, Clay, Red Clay, Shell, etc.	Thick- ness Feet	Depth Feet
Clay & sand	0	21
Soft blk shale	21	27
H Shale	27	55
lime rock str.	55	73
Soft shale	73	83
H shale	83	138
sandy shale	138	153 1/2
shale	153 1/2	156
lime rock shale	156	174
H shale	174	180
lime rock shale	180	200
Soft shale	200	221
shale & sand str.	221	233
C sand	233	250

Information upon completion of well:

(1) Diameter: 4 inches.

(2) Total Depth: 250 feet.

(3) Water Level: 89 feet below top of ground.

(4) Cased to: 157, Size: 4


(5) Screen: Size _____, Length _____

(6) Were any formations sealed against pollution?
_____ yes, no.

If YES depth of formation _____

Why _____

Drillers Remarks: _____

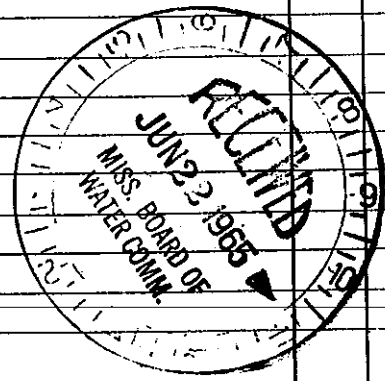

(Use Back Side)

Well No. _____

Mail this copy to Board of Water Commissioners 429 Miss. St. Jackson, Miss.