

Saunderdale
Q3
10-66

Drilled for E-log #4
#1 Masonite - Gray

MISSISSIPPI BOARD OF WATER COMMISSIONERS

WATER WELL DRILLERS LOG

Date: 10-15, 1966, Driller: Grimes Del. DeWitt County, Saunderdale
(When well drilled) (Name) (Where well is located)

(1) Owner of Land: Masonite
(Name)

1766 ft from N line (Address) 7649 ft from E line
(2) Location: 1/4, 1/4, Sec. 2-5N-14E
(distance) (direction) (Nearest Town)

6 miles SW of Meridian
(distance) (direction) (Nearest Town)

(3) Topography: Hilly
(Hilly) (Flat) (Level)

(4) Purpose of Well: Industrial
(Domestic Irrigation, Municipal, Industrial, Other)

Description & Color of Materials Sand, Clay, Red Clay, Shell, etc.	Thick- ness Feet	Depth Feet
<u>red sand</u>	<u>16</u>	<u>16</u>
<u>blue clay + solid rock</u>	<u>44</u>	<u>60</u>
<u>medium grained blue sand</u>	<u>30</u>	<u>90</u>
<u>blue clay + shale streaks</u>	<u>50</u>	<u>140</u>
<u>medium grained blue sand</u>	<u>68</u>	<u>208</u>

Information upon completion of well:

(1) Diameter: 6 inches.

(2) Total Depth: 209 feet.

(3) Water Level: 90 feet below top of ground.

(4) Cased to: 209, Size 3
SLOTTED PIPE

(5) Screen: Size _____, Length 20

(6) Were any formations sealed against pollution?
_____ yes, no.

If YES depth of formation _____


Why _____

Drillers Remarks: Elevation approx 375

Yield in gpm: 60

Size pump: air compressor

Type power: _____

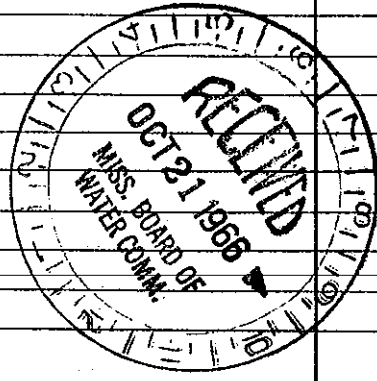

Mail this copy to Board of Water Commissioners 429 Miss. St. Jackson, Miss.