

3 13P

321730 N 0885120

TE MW

Lauderdale
X Q4
9-18-68

MISSISSIPPI
BOARD OF WATER COMMISSIONERS
416 North State Street
Jackson, Mississippi 39201

WATER WELL DRILLERS LOG


9.18.68 date well completed 19 McDONALD + HILL firm name LAUDERDALE county well located

LANDOWNER: KENNETH BOARDMAN
RT #1
Entwainize, MISS
(mailing address)
WELL LOCATION:
sec. 10 T. 5 N R. 14 E
S W
3 miles SOUTH of MEEHAN
(distance) (direction) (nearest town)

description of formations encountered	from to	
	feet	feet
Clay	0	14
Sand	14	50
Shale	50	75
Rock lt shale	75	195
Sand	195	250
Shale	250	260
fine sand lt shale	260	390
Soft shale	390	400
Shale	400	440
Sandy	440	450
Rock	450	454
Shale	454	495
fine sand lt shale	495	560

WELL PURPOSE: HOME
(home, irrigation, municipal, industrial)

WELL COMPLETION DATA:
(1) diameter (inches) 4" WELL
(2) total depth (feet) 560'
(3) static water level (feet) 175' below top of ground.
(4) casing BLACK 400'
(material) (depth)
4" If telescope see back.
(size)
(5) screen NO NO
(length) (depth to top)
1/2" NO
(size) (material)
(6) pump 1 1/2 10
(HP) (yield gpm)
220
(type power)
(7) electric log NO
(yes or no)
NO
(organization running log)
(8) how well bottom plugged O.P.E.K.

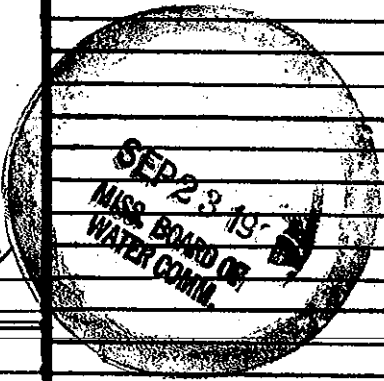

DRILLERS REMARKS: