

Lauderdale
R6
7-67

MISSISSIPPI
BOARD OF WATER COMMISSIONERS
416 North State Street
Jackson, Mississippi 39201
WATER WELL DRILLERS LOG

7-13-67 19 MCDONALD + HILL LAUDERDALE
date well completed firm name county well located

LANDOWNER: BARRET NUNNRY
R#1 MERIDIAN
(mailing address)


WELL LOCATION:
sec. 14 T. 5 N R. 15 E
S W
6 miles S of MERIDIAN
(distance) (direction) (nearest town)

WELL PURPOSE: RESIDE
(home, irrigation, municipal, industrial)

WELL COMPLETION DATA:

- (1) diameter (inches) 4" WELL
- (2) total depth (feet) 270'
- (3) static water level (feet) 38' below top of ground.
- (4) casing BLK, 100'
(material) (depth)
4"
(size) If telescope see back.
- (5) screen NO, NO
(length) (depth to top)
NO, NO
(size) (material)
- (6) pump 1, 10
(HP) (yield gpm)
220
(type power)
- (7) electric log NO
(yes or no)
NO
(organization running log)
- (8) how well bottom plugged OPEN

description of formations encountered	from	to
SAND	0	30
soft sandy shale	30	50
sand	50	80
shale	80	112
soft shale	112	151
shale	151	180
sandy shale	180	215
shale	215	240
fine sand sandy shale	240	270

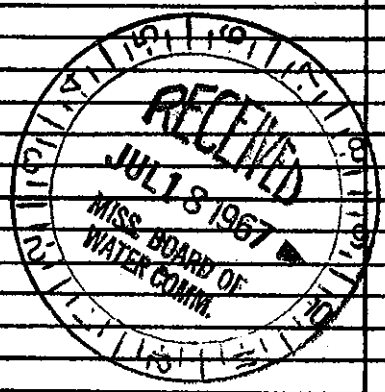

DRILLERS REMARKS: