

LAUD. MISSISSIPPI BOARD OF WATER COMMISSIONERS

WATER WELL DRILLERS LOG

AA R7
5-24-65


Date: 5/24, 1965, Driller: TERRY County: LAUD
(Name)

(1) Owner of Land: HARRY ROUTH
(Name)
VALLEY RD, MDN.
(Address)
(2) Location: 1/4, 1/4, Sec. 3 SW 15E T. R.
3 miles SW of MDN
(distance) (direction) (Nearest Town)
(3) Topography: Hilly
(Hilly) (Flat) (Level)
(4) Purpose of Well: DOMESTIC
(Domestic Irrigation, Municipal, Industrial, Other)

Description & Color of Materials Sand, Clay, Red Clay, Shell, etc.	Thick- ness Feet	Depth Feet
yellow sand & clay	42'	42'
sandy & mudstone	84'	126'
4' Rock		126'
HARD BLUE dirt	174'	300'
sandy shale	93'	393'

Information upon completion of well:

(1) Diameter 4 inches.
(2) Total Depth 393 feet.
(3) Water Level 91 feet below top of ground.
(4) Cased to 191, Size 4"
(5) Screen: Size , Length _____
(6) Were any formations sealed against pollution?
_____ yes, no.
If YES depth of formation _____
Why _____
Drillers Remarks: pumps 109 PM

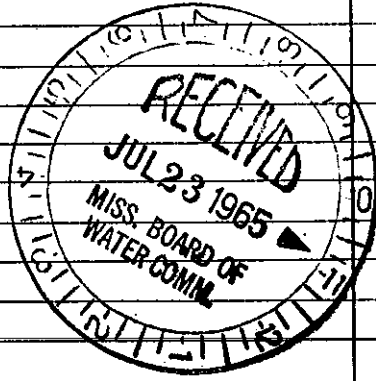

We