

R 8138  
10-27-60

WATER WELL DRILLERS LOG

A 300  
R 8

Date: Oct. 27, 1960, Driller: Perry Drilling Co. County Lauderdale  
(Name)


(1) Owner of Land: Ralph Smith  
(Name)  
Aroundel Springs, Miss  
(Address)  
(2) Location: \_\_\_\_\_ 1/4, \_\_\_\_\_ 1/4, Sec. \_\_\_\_\_ T. R. \_\_\_\_\_  
1 miles North West Aroundel  
(distance) (direction) (Nearest Town)  
(3) Topography: \_\_\_\_\_  
(Hilly) (Flat) (Level)   
(4) Purpose of Well: Domestic  
(Domestic Irrigation) (Municipal, Industrial, Other)

Description & Color of Materials Sand, Clay, Red Clay, Shell, etc.	Thick- ness Feet	Depth Feet
<u>Yellow + white sand</u>	<u>0</u>	<u>16'</u>
<u>Gray dirt</u>	<u>16'</u>	<u>25'</u>
<u>Layers of sand + dirt</u>	<u>25</u>	<u>100'</u>

Information upon completion of well:

(1) Diameter: 3" inches.  
(2) Total Depth: 100 feet.  
(3) Water Level: light flow on ground level feet below top of ground.  
(4) Cased to: 21', Size: 3"  
(5) Screen: Size: open well, Length: \_\_\_\_\_  
(6) Were any formations sealed against pollution?  
yes, \_\_\_\_\_ no.

If YES depth of formation: 25'  
Why: Casing set in tough formation  
Drillers Remarks: \_\_\_\_\_

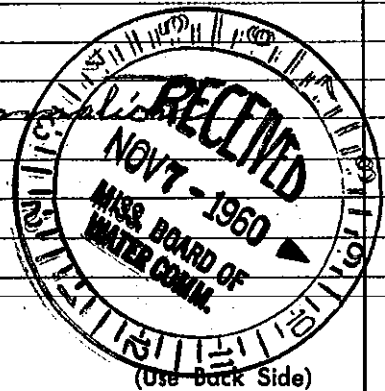

Well No. \_\_\_\_\_

Retain this copy for your office files.