

LAUD, MISSISSIPPI BOARD OF WATER COMMISSIONERS

~~M R 9~~

10-15-65

WATER WELL DRILLERS LOG

Date: 10/15, 1965, Driller: Jerry Drilling  
SEA BROOK County LAUD  
 (Name)

(1) Owner of Land:	Description & Color of Materials Sand, Clay, Red Clay, Shell, etc.	Thick- ness Feet	Depth Feet
<u>ROBERT L. GADDIS</u> (Name)	<u>SANDY YELLOW &amp; RED</u>	<u>0</u>	<u>95</u>
<u>RTS MERIDIAN, MISS</u> (Address)	<u>SANDY SHALE</u>	<u>95</u>	<u>160</u>
(2) Location: <u>1/4</u> , <u>1/4</u> , Sec. <u>3</u> T. <u>R</u>	<u>HARD SHALE</u>	<u>160</u>	<u>270</u>
<u>6</u> miles <u>SOUTH</u> of <u>MDN</u> (distance) (direction) (Nearest Town)	<u>SAND</u>	<u>270</u>	<u>300</u>
(3) Topography: <input checked="" type="radio"/> (Hilly) <input type="radio"/> (Flat) <input type="radio"/> (Level)	<u>DIRT</u>	<u>300</u>	<u>320</u>
(4) Purpose of Well: <u>DOMESTIC</u> (Domestic Irrigation, Municipal, Industrial, Other)			

Information upon completion of well:

(1) Diameter 4 inches.

(2) Total Depth 320 feet.

(3) Water Level 85' feet below top of ground.

(4) Cased to 189, Size 4


(5) Screen: Size No, Length \_\_\_\_\_

(6) Were any formations sealed against pollution?  
 \_\_\_\_\_ yes, \_\_\_\_\_ no.

If YES depth of formation \_\_\_\_\_

Why \_\_\_\_\_

Drillers Remarks: Good water

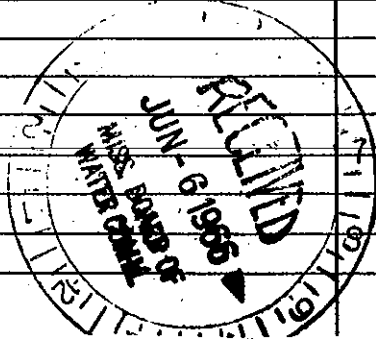

Well