

LAUD.
R12
9-62

MISSISSIPPI BOARD OF WATER COMMISSIONERS

WATER WELL DRILLERS LOG

Date: Sept, 1962, Driller: P. Apple + R. L. Ledge County Saunderdale
(Name)

(1) Owner of Land: <u>Missie Hinneson</u> (Name)	Description & Color of Materials Sand, Clay, Red Clay, Shell, etc.	Thick- ness Feet	Depth Feet
<u>Medicine, Miss</u> (Address)	<u>top soil to yellow</u>		
(2) Location: <u>1/4, 1/4, Sec. 21 T. R.</u>	<u>sandy clay</u>	<u>26</u>	<u>26</u>
<u>Highway 11</u>	<u>gray shale</u>	<u>26</u>	<u>52</u>
<u>5 miles</u> (distance)	<u>gray sandy shale +</u>		
<u>3</u> (direction)	<u>small sand streaks</u>	<u>32</u>	<u>84</u>
<u>Medicine</u> (Nearest Town)	<u>gray shale + black</u>		
(3) Topography: <u>Hilly</u>	<u>lignite streaks</u>	<u>11</u>	<u>95</u>
(4) Purpose of Well: <u>Domestic</u>	<u>gray sandy shale +</u>		
(Domestic Irrigation, Municipal, Industrial, Other)	<u>small gray sand streak</u>	<u>45</u>	<u>140</u>
	<u>gray sand + shale like</u>	<u>28</u>	<u>168</u>
	<u>gray sandy shale</u>	<u>29</u>	<u>197</u>
	<u>Hard rock</u>	<u>3</u>	<u>200</u>


Information upon completion of well:

- (1) Diameter 4 inches.
- (2) Total Depth 200 feet.
- (3) Water Level 40 feet below top of ground.
- (4) Cased to 88, Size 4".
- (5) Screen: Size NONE, Length _____.
- (6) Were any formations sealed against pollution?
_____ yes, _____ no.

If YES depth of formation _____

Why _____

Drillers Remarks: _____

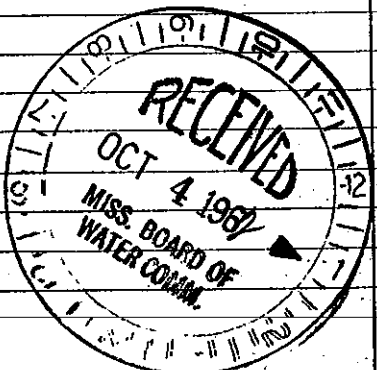

(Use Back Side)

Well No.

Mail this copy to Board of Water Commissioners 429 Miss. St. Jackson, Miss