


WATER WELL DRILLERS LOG

LAUD.
R 13
1-16-64
Date: Jan

1964, Driller: Peoples Drilling County Lauderdale
(Name)

	Description & Color of Materials Sand, Clay, Red Clay, Shell, etc.	Thick- ness Feet	Depth Feet
(1) Owner of Land: <u>JAMES TURNER</u> (Name) <u>SAVOY, Miss</u> (Address)	0-12 Red clay 12-52 yellow sand 52-64 white sand		
(2) Location: <u>1/4</u> , <u>1/4</u> , Sec. <u> </u> T. <u> </u> R. <u> </u> , <u>8</u> miles <u>S</u> of <u>Meridian</u> (distance) (direction) (Nearest Town)			
(3) Topography: <u>Hilly</u> (Hilly) (Flat) (Level)			
(4) Purpose of Well: <u>Domestic</u> (Domestic Irrigation Municipal, Industrial, Other)			
Information upon completion of well:			
(1) Diameter <u>2"</u> inches.			
(2) Total Depth <u>65'</u> feet.			
(3) Water Level <u>60</u> feet below top of ground.			
(4) Cased to <u>65'</u> , Size <u>2"</u>			
(5) Screen: Size <u>2"</u> , Length <u>6'</u>			
(6) Were any formations sealed against pollution? <u> </u> yes, <u> </u> no.			
If YES depth of formation <u> </u>			
Why <u> </u>			
Drillers Remarks: <u> </u> <u> </u> <u> </u>			Well No.

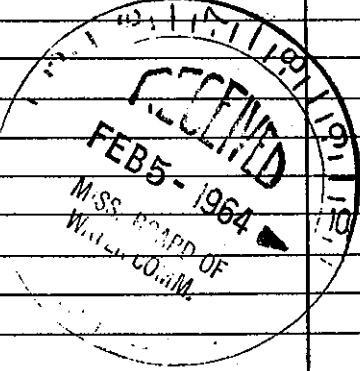

(Use Back Side)

Mail this copy to Board of Water Commissioners 429 Miss. St. Jackson, Miss.