

3 13P

321655N0884750

TEHA

looks like
Cochis

Lauderdale
R18
7-31-68

MISSISSIPPI
BOARD OF WATER COMMISSIONERS
416 North State Street
Jackson, Mississippi 39201

WATER WELL DRILLERS LOG

July 31 1968 Williamson Drilling Co. Lauderdale
date well completed firm name county well located

LANDOWNER: M. J. Hunt
Pt 1 Valley Rd.
(mailing address)


WELL LOCATION:
sec. 1 T. 5 N R. 15 W
2 miles south of Indian
(distance) (direction) (nearest town)

WELL PURPOSE: home
(home, irrigation, municipal, industrial)

WELL COMPLETION DATA:

- (1) diameter (inches) 4 1/2
- (2) total depth (feet) 191
- (3) static water level (feet) 34 (below/above top of ground)
- (4) casing black (material), 87 (depth)
- 4 (size) if telescope see back.
- (5) screen no (length), (depth to top)
- (size) (material)
- (6) pump 1/2 (HP), 5 (yield gpm)
- Electric (type power)
- (7) electric log no (yes or no)
- no (organization running log)
- (8) how well bottom plugged open

description of formations encountered	from	to
Blue Clay	0	10
Blue Clay	10	30
Blue Clay	30	120
sand & iron shells	120	130
Blue Clay	130	150
gray sand	150	191

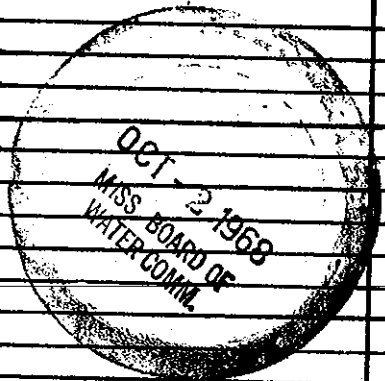

DRILLERS REMARKS: packed 135
set casing