

LAUDERDALE  
R 26  
3-68

MISSISSIPPI  
BOARD OF WATER COMMISSIONERS  
416 North State Street  
Jackson, Mississippi 39201

**CODED**

WATER WELL DRILLERS LOG

3.14.68 19 MCDONALD + HILL LAUDERDALE  
date well completed firm name county well located

LANDOWNER: HICKORY LAKES  
R# 5 MERIDIAN  
  
(mailing address)

WELL LOCATION:  
sec 14 T 5 N R 15 E  
4 miles SOUTH W MERIDIAN  
(distance) (direction) (nearest town)


WELL PURPOSE: HOME  
(home, irrigation, municipal, industrial)

WELL COMPLETION DATA:

- (1) diameter (inches) 4" WELL
- (2) total depth (feet) 180'
- (3) static water level (feet) 40' below top of ground.
- (4) casing PVC 100'  
(material) (depth)  
4"  
(size) if telescope see back.
- (5) screen NO NO  
(length) (depth to top)  
NO NO  
(size) (material)
- (6) pump 1/2 JET 10  
(HP) (yield gpm)  
220  
(type power)
- (7) electric log NO  
(yes or no)  
NO  
(organization running log)
- (8) how well bottom plugged OPEN

description of formations encountered	from	to
Sand Lt Clay	0	12
shale	12	54
Sandy	54	75
shale	75	105
Sand Lt Shale	105	120
Soft shale	120	137
Sand Lt shale	137	140
Soft Sand	140	145
shale Lt Lignite	145	155
Sand Lt Shale	155	180

**CODED**

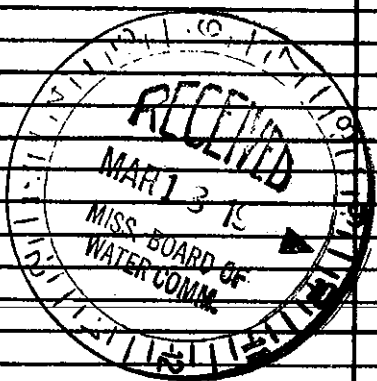

DRILLERS REMARKS:  
over