

LAUD. MISSISSIPPI BOARD OF WATER COMMISSIONERS

R 27 hrs. into to locate
WATER WELL DRILLERS LOG

CODED

5-1-61
Date: 5-1, 1961, Driller: M^r Donald J Hill County Lauderdale
(Name)

(1) Owner of Land: R.C. Ellis
(Name)
Rt #1, Mendon, Miss
(Address)

(2) Location: 3/4, 2 Sec. S.T.R.
5 miles S, of Mendon
(distance) (direction) (Nearest Town)

(3) Topography: (Hilly) (Flat) (Level)

(4) Purpose of Well: Domestic
(Domestic Irrigation, Municipal, Industrial, Other)

Description & Color of Materials Sand, Clay, Red Clay, Shell, etc.	Thick- ness Feet	Depth Feet
Clay	0	8
Clay & Sand	8	40
Sand	40	55
Shale	55	98
Sand	98	102
Rock	102	105
Soft Shale & Sand	105	116
Shale	116	126
Soft Shale	126	160
Sandy Shale	160	170
Soft Shale	170	190
Shale	190	230
Soft to med. Shale	230	265
Rock	265	272
Fine Sand	272	310

Information upon completion of well:

(1) Diameter 4 inches.

(2) Total Depth 310 feet.


(3) Water Level 11' feet below top of ground.

(4) Cased to 126', Size 4"

(5) Screen: Size None, Length _____

(6) Were any formations sealed against pollution?
_____ yes, no.

CODED

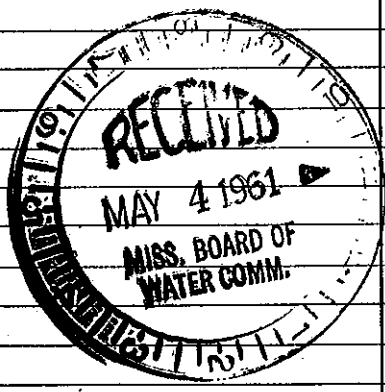

If YES depth of formation _____

Why _____

Drillers Remarks: _____

Well No.

(Use Back Side)

Mail this copy to Board of Water Commissioners 429 Miss. St. Jackson, Miss.