

LAUD.  
R28  
12-4-61

MISSISSIPPI BOARD OF WATER COMMISSIONERS

WATER WELL DRILLERS LOG

**CODED**

Date: 12.4, 1961, Driller: McDONALD HILL County: LAUDERDALE  
(Name)

(1) Owner of Land: F. C. THOMPSON  
(Name)  
R#1 MERIDIAN  
(Address)  
(2) Location: 5-11 Sec. T R  
5 miles SOUTH, MERIDIAN  
(distance) (direction) (Nearest Town)  
(3) Topography: X  
(Hilly) (Flat) (Level)  
(4) Purpose of Well: DOMESTIC  
(Domestic Irrigation, Municipal, Industrial, Other)

Description & Color of Materials Sand, Clay, Red Clay, Shell, etc.	Thick- ness Feet	Depth Feet
CLAY	0	20
LIGNITE SHALE	20	40
SOFT SHALE	40	132
ROCK	132	135
SOFT SANDY SHALE	135	190
SHALE	190	292
ROCK	292	298
SAND SHALE	298	320
FINE SAND	320	350


Information upon completion of well:

- (1) Diameter 3" inches.  
(2) Total Depth 350' feet.  
(3) Water Level 90' feet below top of ground.  
(4) Cased to 210', Size 3"  
(5) Screen: Size \_\_\_\_\_, Length \_\_\_\_\_  
(6) Were any formations sealed against pollution?  
\_\_\_\_\_ yes, \_\_\_\_\_ no.

If YES depth of formation \_\_\_\_\_

Why \_\_\_\_\_

Drillers Remarks: \_\_\_\_\_

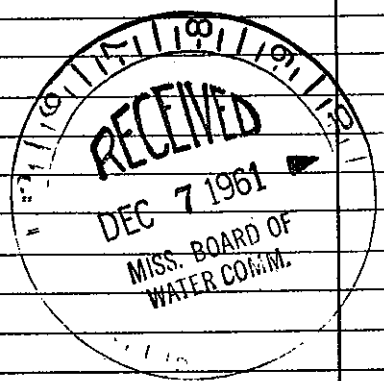

(Use Back Side)

Well No.

Mail this copy to Board of Water Commissioners 429 Miss. St. Jackson, Miss.