

LAUD.  
R 29  
1-30-62

MISSISSIPPI BOARD OF WATER COMMISSIONERS

**CODED**

**WATER WELL DRILLERS LOG**


McDONALD & HILL, Inc.

Date: 11-30, 1962, Driller: \_\_\_\_\_ P.O. Box 81 County Lauderdale

Meridian, Mississippi

	Description & Color of Materials Sand, Clay, Red Clay, Shell, etc.	Thick- ness Feet	Depth Feet
(1) Owner of Land <u>Larry Taylor</u> (Name)	Clay	0	20
<u>Rt # 1 Meridian</u> (Address)	Sand	20	44
(2) Location: <u>35</u> <u>15</u> 1/4, Sec. T. R.	Sand	44	43
<u>5</u> miles <u>S</u> of <u>Meridian</u> (distance) (direction) (Nearest Town)	y. Clay	45	48
(3) Topography: _____ (Hilly) (Flat) (Level)	med. Shales	48	70
(4) Purpose of Well: <u>Domestic</u> (Domestic Irrigation Municipal, Industrial, Other)	Shales	70	160
Information upon completion of well:	Sand	160	206
(1) Diameter <u>4</u> inches.	Red Sand	205	218
(2) Total Depth <u>280</u> feet.	Sand	218	242
(3) Water Level <u>252</u> feet below top of ground.	H Shales	242	253
(4) Cased to <u>252</u> , Size <u>4"</u>	med. Shales	253	257
(5) Screen: Size <u>Steel</u> , Length <u>4</u>	Hard Shales	257	265
(6) Were any formations sealed against pollution? _____ yes, _____ no.	Sand	265	285
If YES depth of formation _____	Sandy Shales	285	290
Why _____	Hard Shales	290	350
Drillers Remarks: _____	Sand	350	372
	Sandy line	372	380

**CODED**

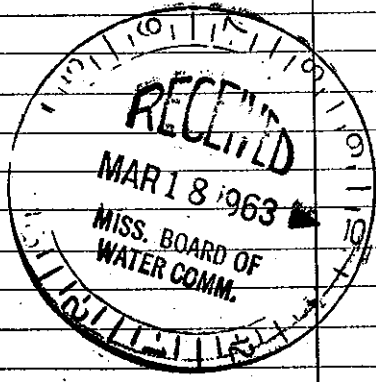

Well No.

(Use Back Side)

Retain this copy for your office files.