

LAUD.

MISSISSIPPI BOARD OF WATER COMMISSIONERS

R30
5-21-62

WATER WELL DRILLERS LOG

CODED

Date: 5-21, 1962, Driller: M^eDonald Hill County Lauderdale
(Name)

		Description & Color of Materials Sand, Clay, Red Clay, Shell, etc.	Thick- ness Feet	Depth Feet
(1) Owner of Land: <u>Henry M. McClinton</u> (Name)		<u>Clay</u>	<u>0</u>	<u>10</u>
<u>Rt #5, Meridian, Miss</u> (Address)		<u>Sand & Shale</u>	<u>10</u>	<u>20</u>
(2) Location: <u>1/4, 1 1/4, Sec. 5 T. 15</u>		<u>Shale</u>	<u>40</u>	<u>20</u>
<u>5</u> miles <u>South</u> , of <u>Meridian</u> (distance) (direction) (Nearest Town)		<u>Soft Shale</u>	<u>90</u>	<u>130</u>
(3) Topography: <input checked="" type="checkbox"/> (Hilly) <input type="checkbox"/> (Flat) <input type="checkbox"/> (Level)		<u>Fine Sand</u>	<u>130</u>	<u>160</u>
(4) Purpose of Well: <u>Domestic</u> (Domestic Irrigation Municipal, Industrial, Other)		<u>Sandy Shale</u>	<u>160</u>	<u>180</u>


Information upon completion of well:

- (1) Diameter 2 inches.
- (2) Total Depth 180 feet.
- (3) Water Level 21' feet below top of ground.
- (4) Cased to 84, Size 4"
- (5) Screen: Size NONE, Length _____
- (6) Were any formations sealed against pollution?
_____ yes, no.

If YES depth of formation _____

Why _____

Drillers Remarks: _____

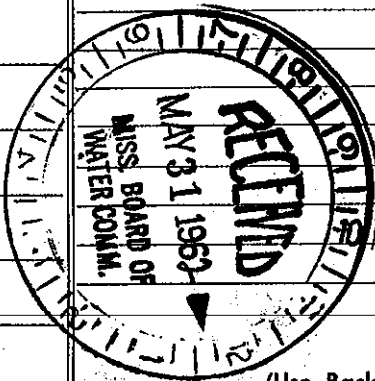

(Use Back Side)

Well No. _____

Mail this copy to Board of Water Commissioners 429 Miss. St. Jackson, Miss