

LAUD.

MISSISSIPPI BOARD OF WATER COMMISSIONERS

R 33
10-22-62

WATER WELL DRILLERS LOG

CODED

Date: 10-22, 1962, Driller: McDONALD & HILL, Inc. County: Laud.

P. O. BOX 81

MERIDIAN, MISSISSIPPI

(1) Owner of Land: Richard Conley
(Name)
Rt # 5 Meridian
(Address)

(2) Location: 1/4, 1/4, Sec. 5 15 T R
5 miles SE of Meridian
(distance) (direction) (Nearest Town)

(3) Topography: (Hilly) (Flat) (Level)

(4) Purpose of Well: Domestic
(Domestic Irrigation, Municipal, Industrial, Other)

Description & Color of Materials Sand, Clay, Red Clay, Shell, etc.	Thick- ness Feet	Depth Feet
Sand	0	70
Shale	70	80
Sand	80	95
Shale	95	180
fine sand	180	230

Information upon completion of well:

(1) Diameter: 3 inches.

(2) Total Depth: 230 feet.

(3) Water Level: 105 feet below top of ground.

(4) Cased to: 168, Size: 3

(5) Screen: Size, Length


(6) Were any formations sealed against pollution?
yes, no.

If YES, depth of formation

Why

Drillers Remarks:

CODED

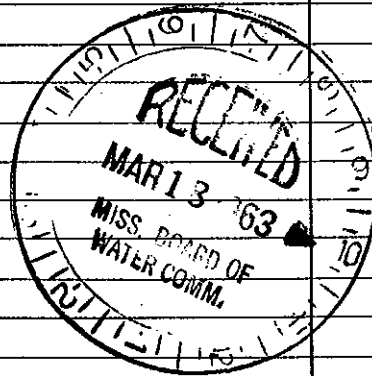

Well No.

(Use Back Side)

Mail this copy to Board of Water Commissioners 429 Miss. St. Jackson, Miss.