

LAUD.

MISSISSIPPI BOARD OF WATER COMMISSIONERS

R34

12-22-62

WATER WELL DRILLERS LOG

McDONALD & HILL, Inc.

CODED

Date: 12-22, 1962, Driller: _____ County: Laud

(Name)

(1) Owner of Land: <u>L. L. Dukes</u> (Name) <u>Valley Road</u> (Address)		Description & Color of Materials Sand, Clay, Red Clay, Shell, etc.	Thick-ness Feet	Depth Feet
(2) Location: _____ 1/4, _____ 1/4, Sec. <u>51</u> , T. <u>R1</u> , <u>3</u> miles <u>8</u> of <u>McDon</u> (distance) (direction) (Nearest Town)		<u>Clay</u>	<u>0</u>	<u>10</u>
(3) Topography: _____ (Hilly) (Flat) (Level)		<u>Sand</u>	<u>10</u>	<u>14</u>
(4) Purpose of Well: <u>Domestic</u> (Domestic Irrigation Municipal, Industrial, Other)		<u>Sand + Shale</u>	<u>14</u>	<u>136</u>
		<u>Sand + Shale st.</u>	<u>137</u>	<u>335</u>

Information upon completion of well:

(1) Diameter 3 inches.

(2) Total Depth 335 feet.

(3) Water Level 40 feet below top of ground.

(4) Cased to 116, Size 3.

(5) Screen: Size _____, Length _____.


(6) Were any formations sealed against pollution?
_____ yes, no.

If YES, depth of formation _____

Why _____

Drillers Remarks: _____

CODED

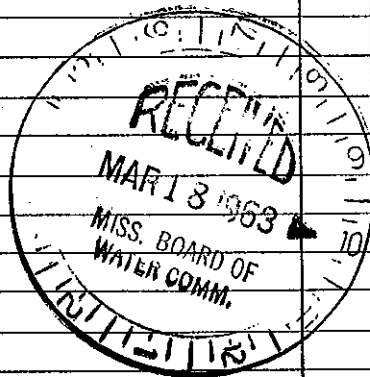

Well No. _____

(Use Back Side)

Mail this copy to Board of Water Commissioners 429 Miss. St. Jackson, Miss.