

MISSISSIPPI BOARD OF WATER COMMISSIONERS

WATER WELL DRILLERS LOG

CODED

LAND.

R 38

7-8-64

Date: 7-8, 1964, Driller: M. C. Donald & Hill, Inc. Landendale

Boman Building & Supply Co. (Name)

(1) Owner of Land: J. C. BOMAR (Name)

R#6 MERIDIAN (Address)


(2) Location: 1/4, 1/4, Sec. 3 5 15 T. R.

miles of (distance) (direction) (Nearest Town)

(3) Topography: X (Hilly) (Flat) (Level)

(4) Purpose of Well: DOMESTIC (Domestic Irrigation, Municipal, Industrial, Other)

Description & Color of Materials Sand, Clay, Red Clay, Shell, etc.	Thick- ness Feet	Depth Feet
CLAY	0	12
SAND ST CLAY	12	38
SHALE	38	120
SOFT SANDY	120	160
SHALE ST LIGNITE	160	245
SAND	245	255
SHALE	255	380
SAND	380	400

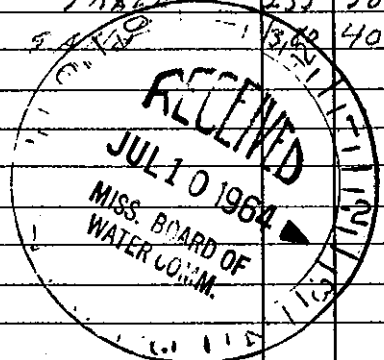

Information upon completion of well:

(1) Diameter 4" inches.

(2) Total Depth 400' feet.

(3) Water Level 180' feet below top of ground.

(4) Cased to 231', Size 4"

(5) Screen: Size _____, Length _____

(6) Were any formations sealed against pollution?
_____ yes, _____ no.

If YES depth of formation _____

Why _____

Drillers Remarks: _____

CODED

(Use Back Side)

Well No.

Mail this copy to Board of Water Commissioners 429 Miss. St. Jackson, Miss